


# T.5S. R.1W., W.M

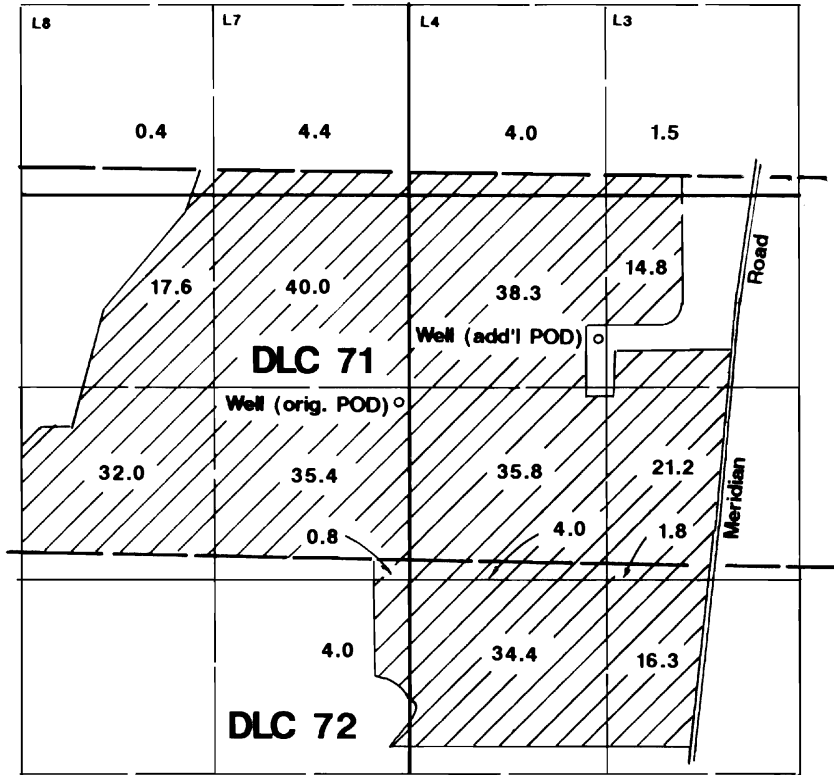

Well (orig. POD) is located 1430'S & 30'W from NE corner Section 11.  
 Well (add'l POD) is located 980'S & 1400'E from NE corner Section 11.

**RECEIVED**

**MAY 04 1998**

**WATER RESOURCES DEPT.  
 SALEM, OREGON**

## Final Proof Survey

Transfer #: T-7593

In Name Of

**Raymond Schwabauer**

Surveyed on April 25, 1998 by JM Schuette

This Map Was Prepared For The Purpose Of Identifying The Location Of A Water Right Only And Is Not Intended To Provide Legal Dimensions Or Location Of Property Ownership Lines.

