


T. 6 S. R. 2 W. W.M. NORPAC BROOKS PLANT

IRRIGATION USE

4" = 1 MI.

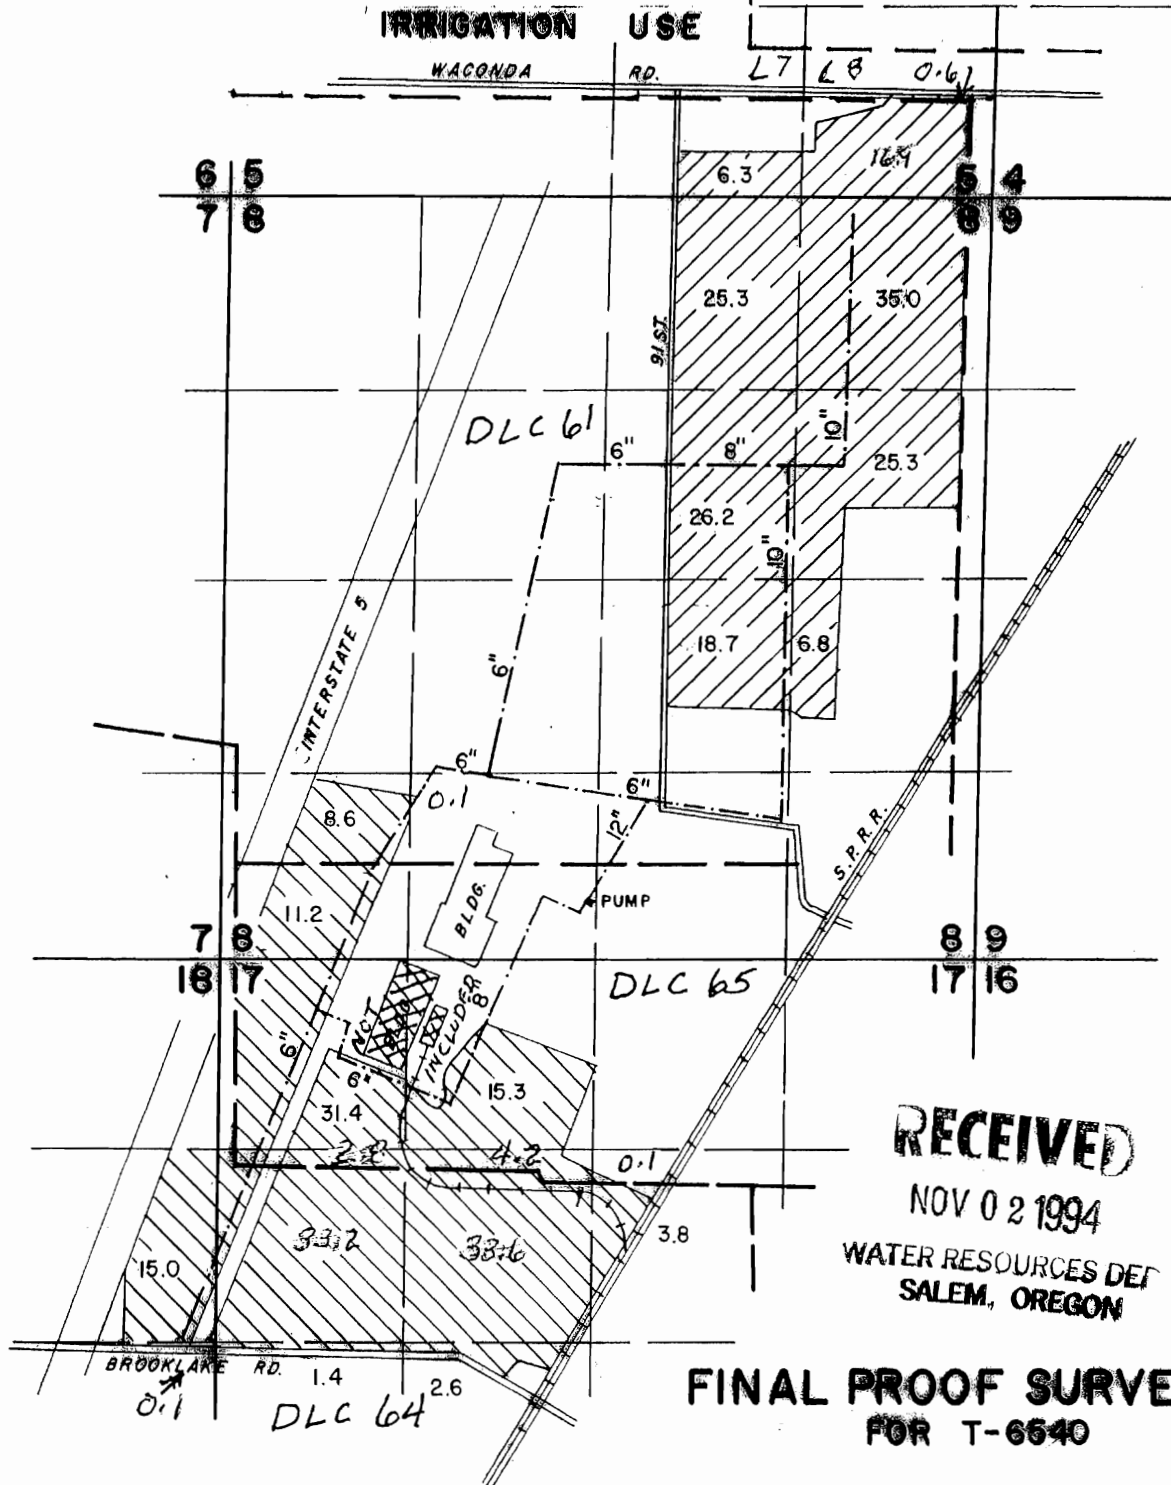

RECEIVED

NOV 02 1994

WATER RESOURCES DEPT
SALEM, OREGON

**FINAL PROOF SURVEY
FOR T-6640**

BY:



THIS MAP WAS PREPARED FOR THE
PURPOSE OF IDENTIFYING THE LOCATION
OF A WATER RIGHT ONLY AND IS
NOT INTENDED TO PROVIDE LEGAL
DIMENSIONS OR LOCATION OF PROPERTY
OWNERSHIP LINES.

AMENDED 4/12/07 LHN WRD