
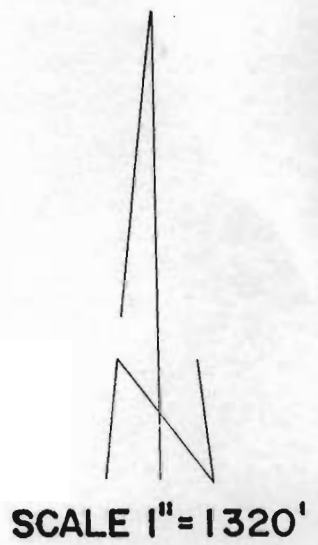


T. 4S., R. 12 & 13E., W. M.

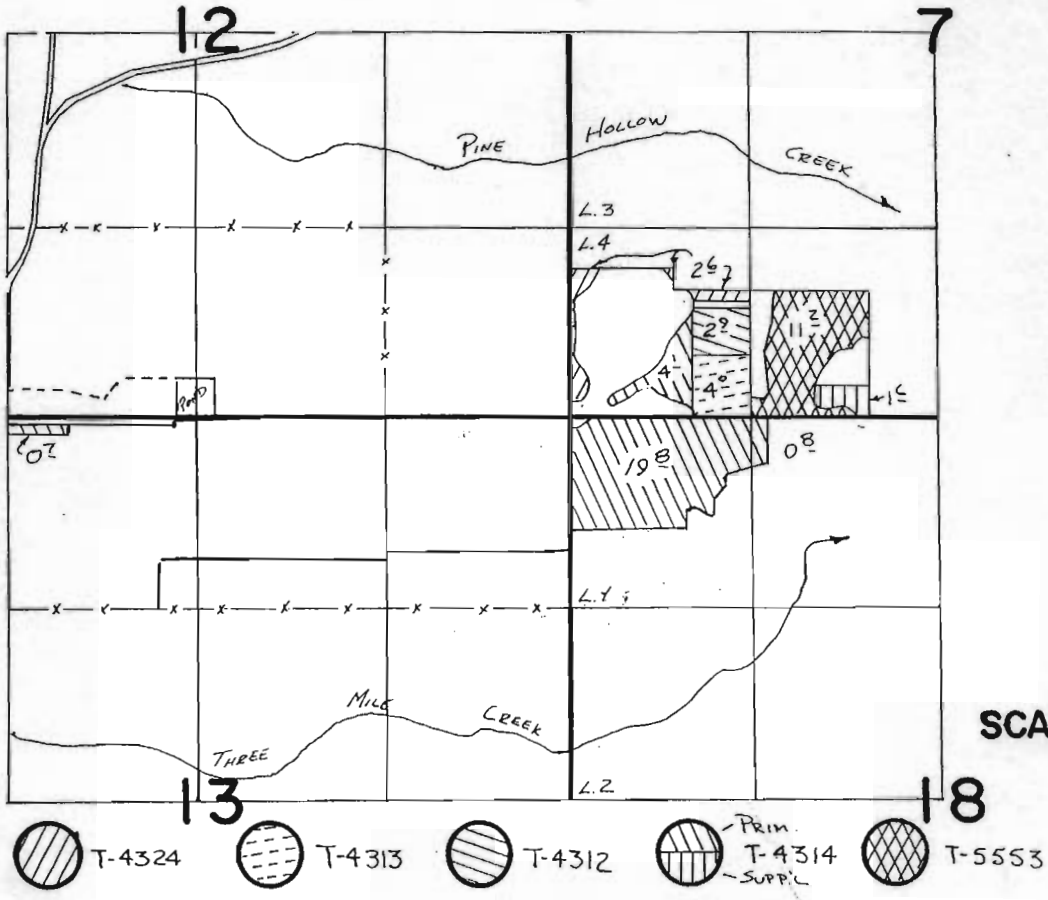

FINAL PROOF SURVEY
UNDER

TRANSFERS 4324, 4313, 4312, 4314, 5553
IN NAME OF

.....**RAY A. BENZEL**.....

Surveyed 10-18 1988, by V.H. Church.....