

T. 8 S. R. 3 8 E. W. M.




TEMPORARY TRANSFER

KERNS RAINBOW RANCH, INC

RECEIVED

APR 19 1999

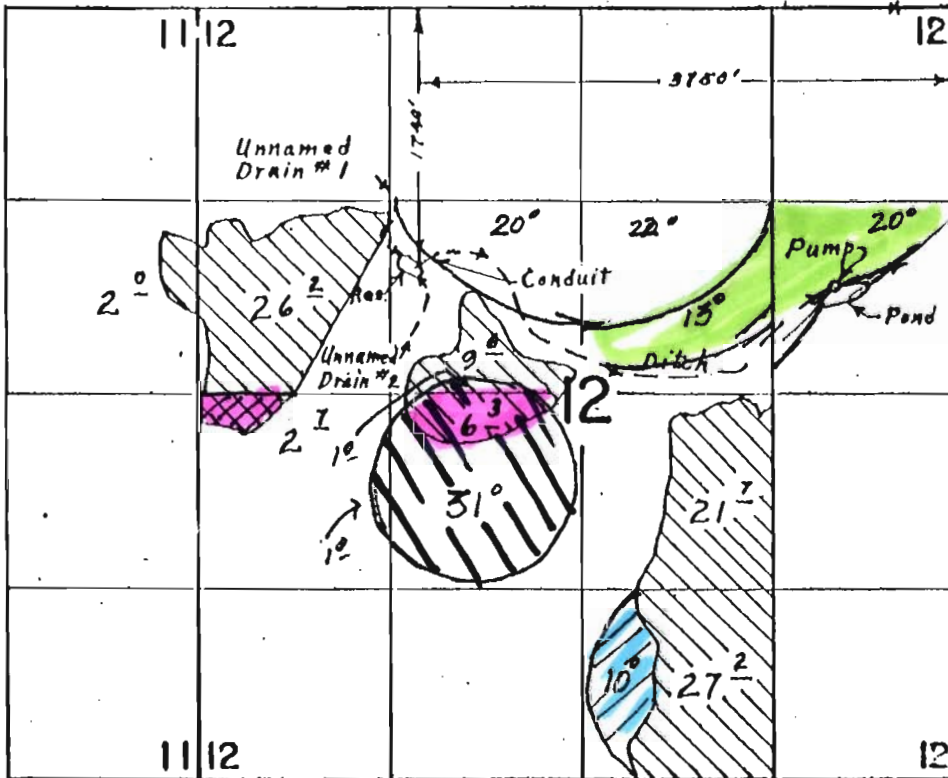

WATER RESOURCES DEPT.
SALEM, OREGON




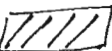
C 67787

 FROM
 TO

C 32743

 FROM
 TO

C 5547

 FROM
 TO

FINAL PROOF SURVEY

UNDER

R44246

R5048

Application No. 43132 Permit No. 32743

IN NAME OF

MARCUS SACKOS

Surveyed Aug. 13, 1970, by L. E. Gould