

RECEIVED

MAR 24 1999


WATER RESOURCES DEPT
SALEM, OREGON

Duane Boyer
Rt. 1 Box 108

T-8225

Haines, AR 97833

T 7 S R 38 E

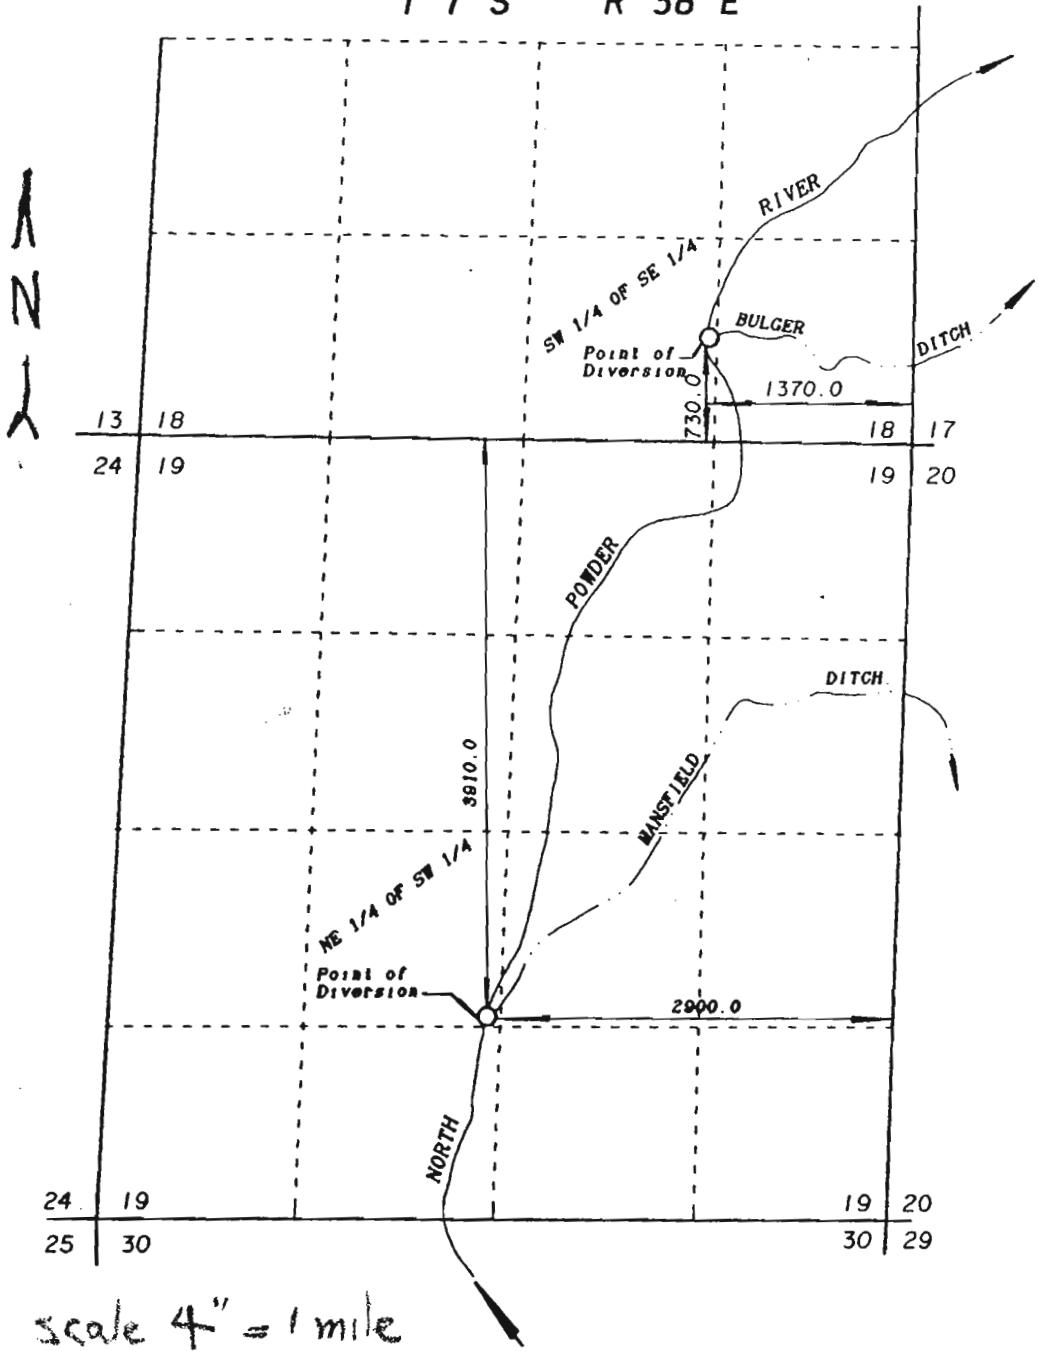

scale 4" = 1 mile

**AUTHORIZED POINTS OF DIVERSION
FOR BULGER DITCH AND
MANSFIELD DITCH.**

Prepared by Duane Boyer