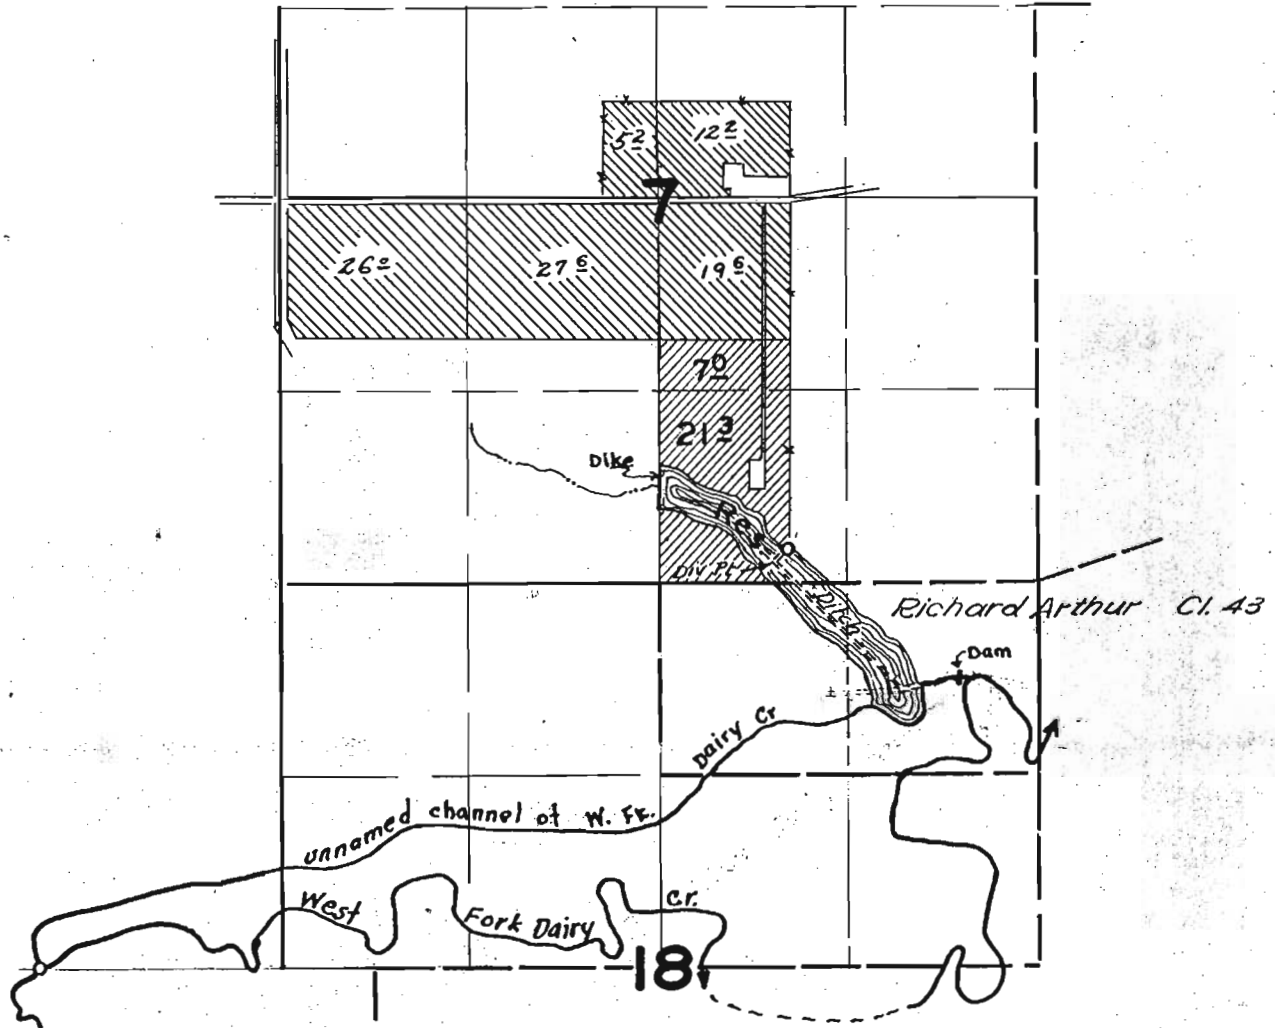

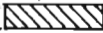


TIN.R.3W.W.M.



# FINAL PROOF SURVEY

UNDER

Application No. 24371 Permit No. 21230   
 Application No. 24372 Permit No. 19231 

IN NAME OF

**A.L. & P.E. VANDEHEY**  
 EDWARD H. VANDER ZANDEN

Surveyed April 17 1956 by R. H. WHITBY  
June 11, 1952, by H. L. COFFMAN

1952 C