

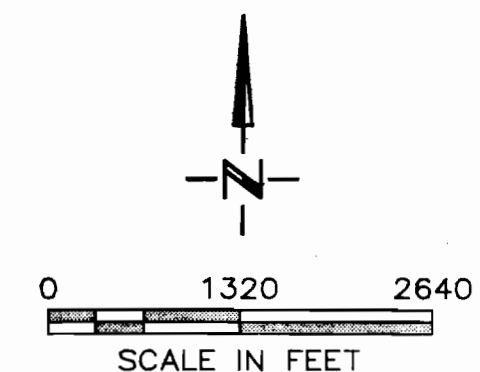


BUTTER CREEK IRRIGATION DISTRICT FINAL PROOF SURVEY T-7545 T. 2 N., R. 27 E. WM.

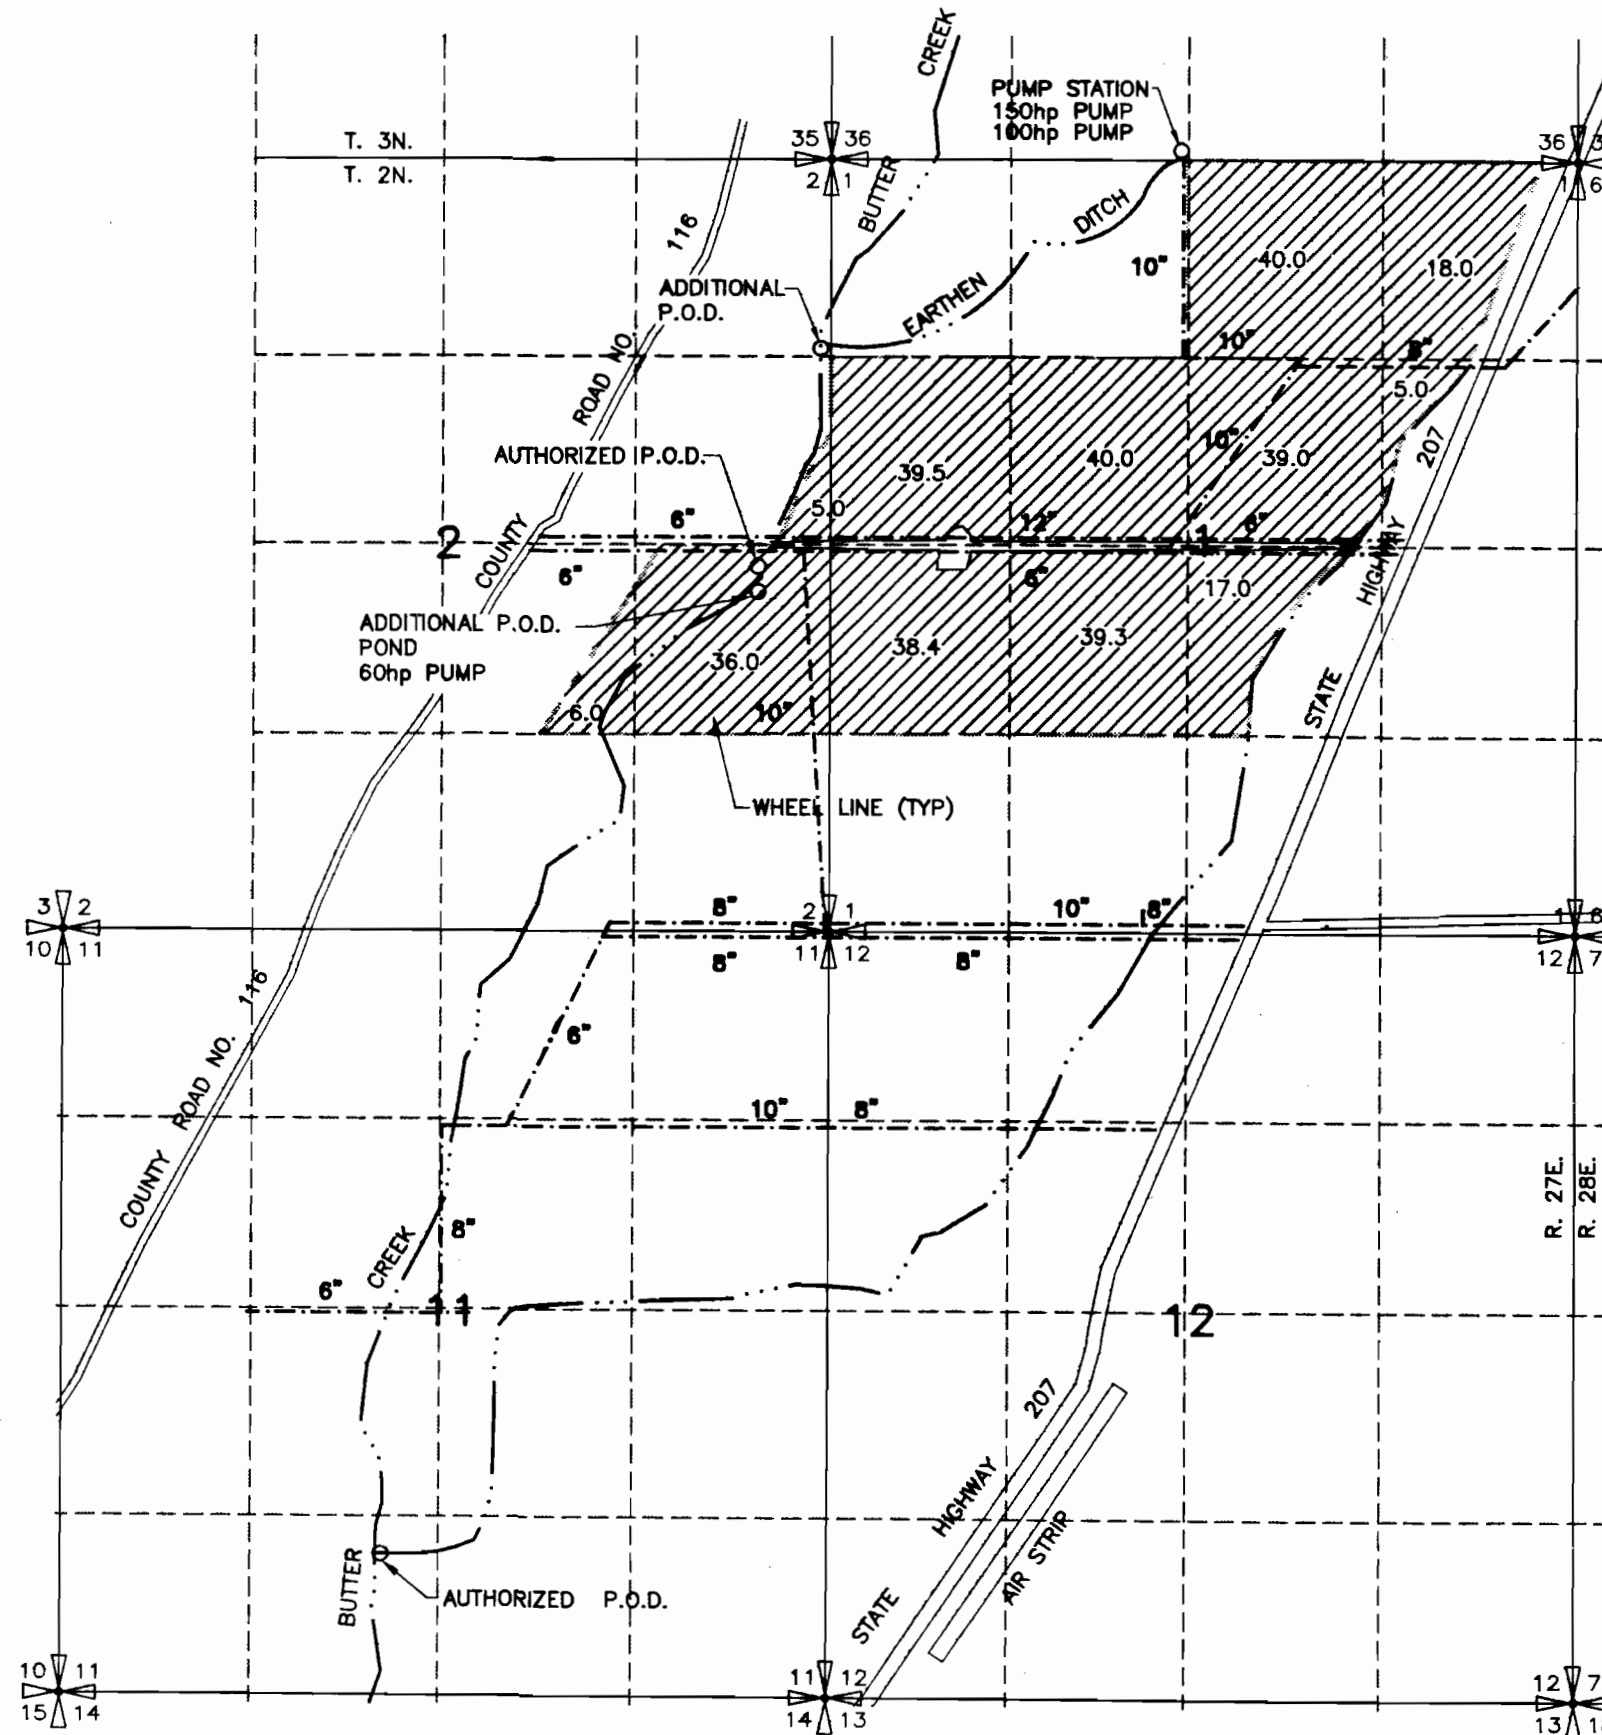

- 6" DISTRIBUTION SYSTEM
- AREA OF BENEFICIAL USE
IRRIGATED WITH WHEEL LINES AND HAND LINES
- AUTHORIZED P.O.D 50' S AND 350' W FROM E 1/4 CORNER SECTION 2
- AUTHORIZED P.O.D. 970' N AND 450' W FROM S 1/4 CORNER SECTION 11
- ADDITIONAL P.O.D. 1290' S AND 80' W FROM NE CORNER SECTION 2
- ADDITIONAL P.O.D. 2920' S AND 500' W FROM NE CORNER SECTION 2

NOTE: THE PURPOSE OF THIS MAP IS TO IDENTIFY THE APPROXIMATE LOCATION OF THE WATER RIGHT. IT IS NOT INTENDED TO PROVIDE INFORMATION RELATIVE TO THE LOCATION OF PROPERTY OWNERSHIP BOUNDARY LINES.

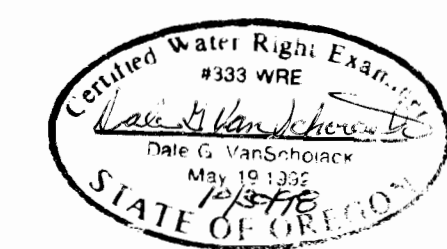

3522.031
SEPTEMBER 30, 1998
3522BTFP.DWG