

AUTHORIZED POINTS OF DIVERSION

COMMON CORNER OF SECTIONS 4, 5, 8 & 9, T 2 N, R 24 E, W.M.



AUTHORIZED FOR PERMIT NOS. 41644 & 41645.

2522.16' N. 50°56' 22" W. FROM SE CORNER SECTION 36, T 4 N, R 22 E, W.M.
BEING WITHIN NW SE OF SECTION 36.

AUTHORIZED FOR PERMIT NOS. 41314.
41644 & 41645 (assumed).



SCALE 1" = 1320'

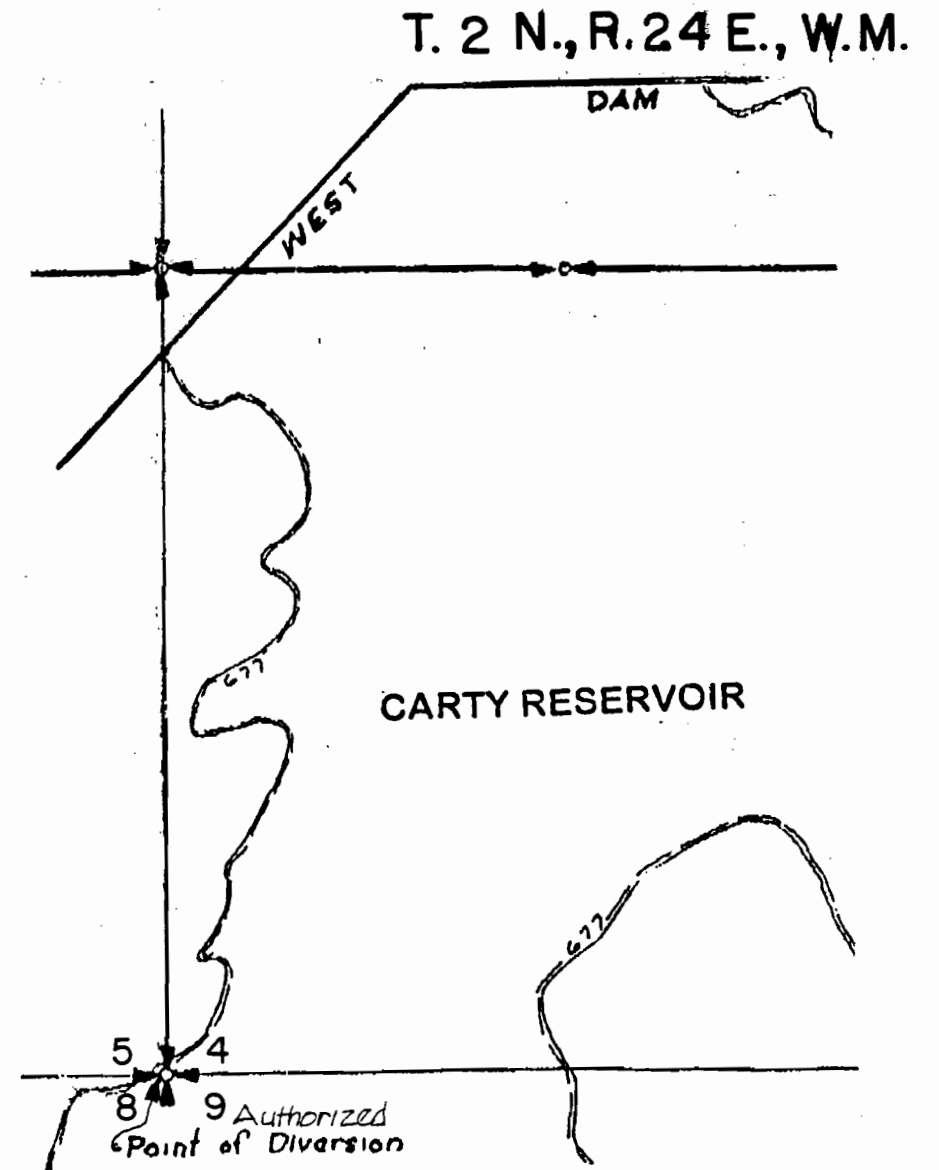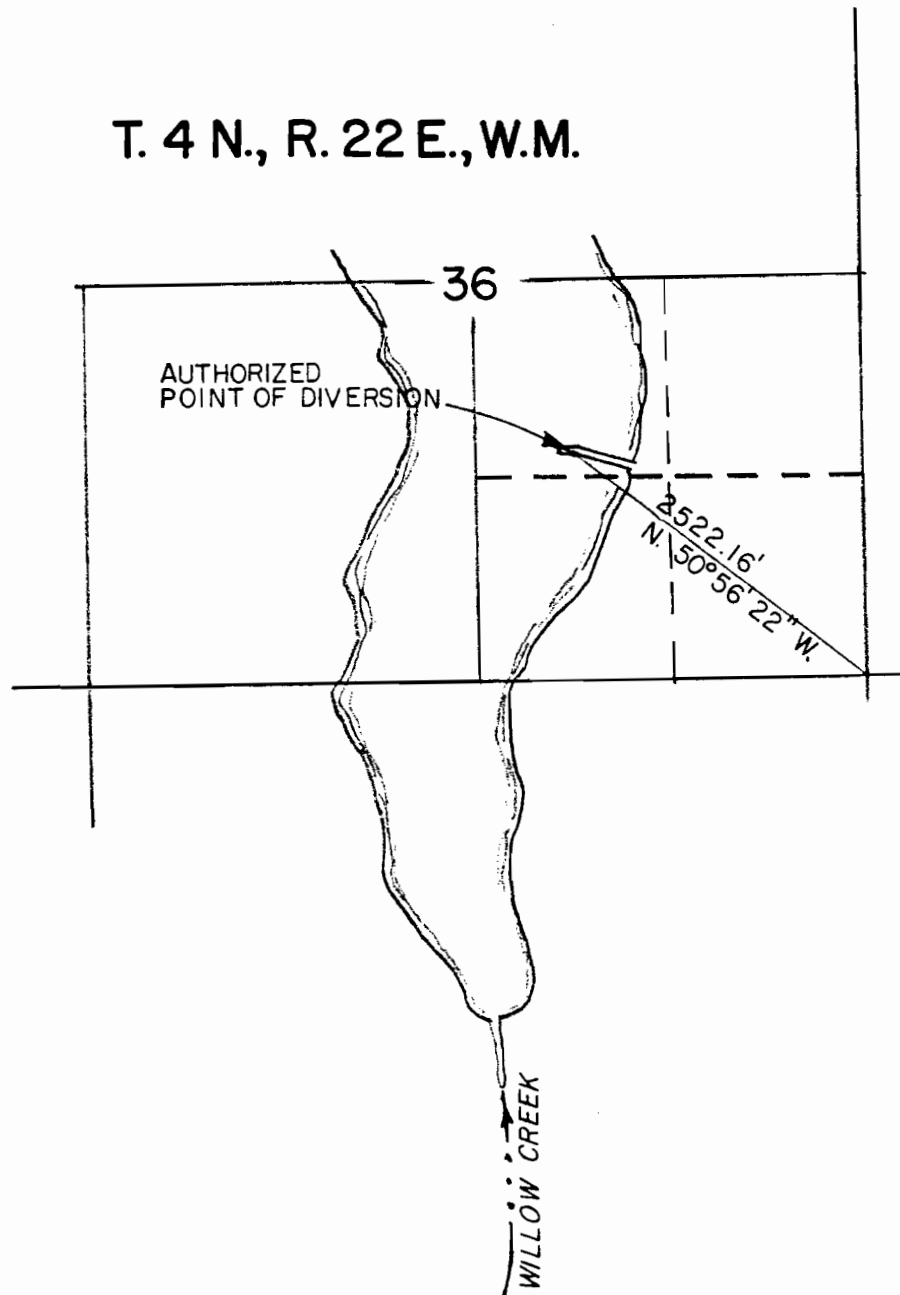


BOEING AGRI-INDUSTRIAL CO.

T-7541


The preparation of this map is for the purpose of identifying the location of water rights only, and has no intent to provide dimensions or locations of property ownership lines.

T. 4 N., R. 23 E., W.M.

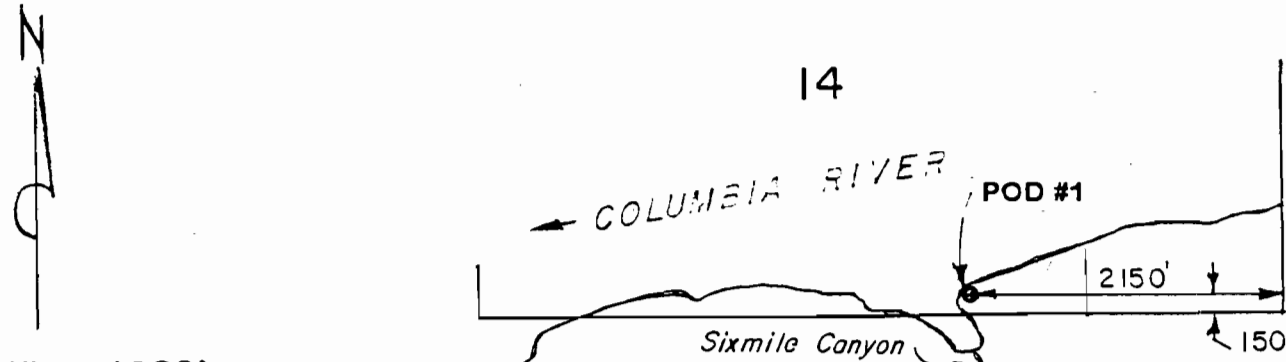

P.O.D. #1 - Approximately 150 Feet North and 2150' West from the Southeast Corner of Section 14, Township 4 North, Range 23 East, W.M.


T. 4 N., R. 23 E., W.M.

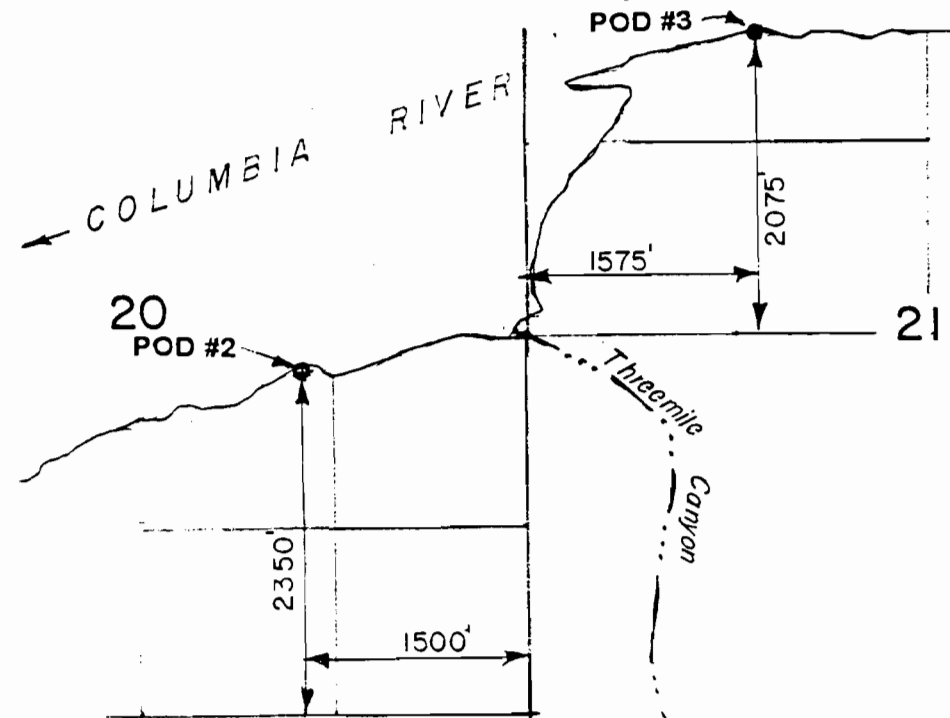

P.O.D. #2 - Approximately 2350 Feet North and 1500 Feet West from the Southeast Corner of Section 20, Township 4 North, Range 23 East, W.M.

P.O.D. #3 - Approximately 2075 feet North and 1575 Feet East from the West 1/4 Corner of Section 21, Township 4 North, Range 23 East, W.M.

T. 4 N., R. 24 E., W.M.

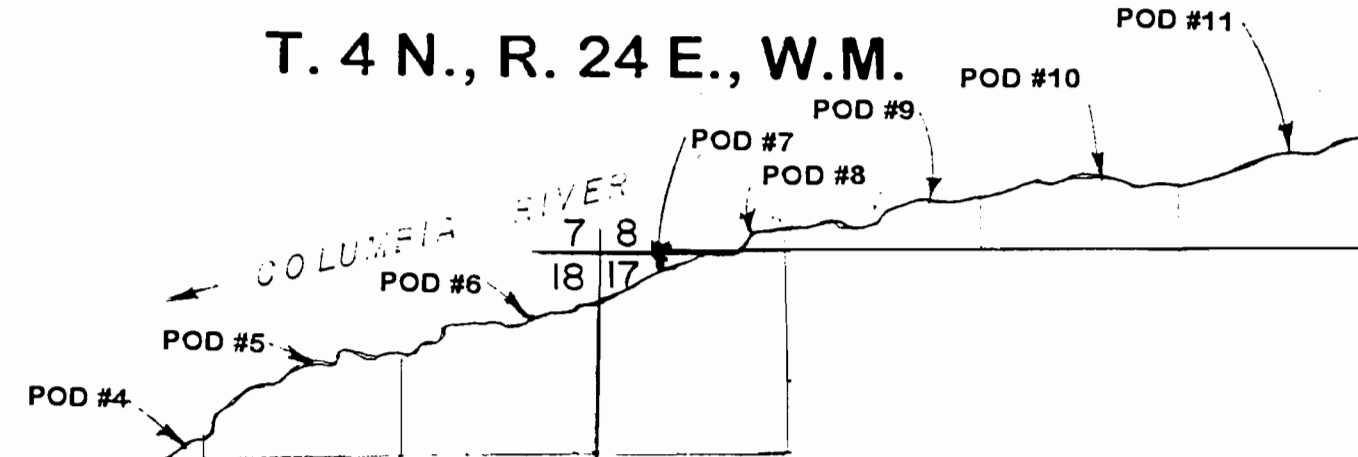

- P.O.D. #4 - Within the Northeast 1/4 of the Northwest 1/4 of Section 18, Township 4 North, Range 24 East, W.M.
- P.O.D. #5 - Within the Northwest 1/4 of the Northeast 1/4 of Section 18, Township 4 North, Range 24 East, W.M.
- P.O.D. #6 - Within the Northeast 1/4 of the Northeast 1/4 of Section 18, Township 4 North, Range 24 East, W.M.
- P.O.D. #7 - Within the Northwest 1/4 of the Northwest 1/4 of Section 17, Township 4 North, Range 24 East, W.M.
- P.O.D. #8 - Within the Southwest 1/4 of the Southwest 1/4 of Section 8, Township 4 North, Range 24 East, W.M.
- P.O.D. #9 - Within the Southeast 1/4 of the Southwest 1/4 of Section 8, Township 4 North, Range 24 East, W.M.
- P.O.D. #10 - Within the Southwest 1/4 of the Southeast 1/4 of Section 8, Township 4 North, Range 24 East, W.M.
- P.O.D. #11 - Within the Southeast 1/4 of the Southeast 1/4 of Section 8, Township 4 North, Range 24 East, W.M.

APPLICATION

FOR


ADDITIONAL POINTS OF DIVERSION

UNDER

APPLICATION NO. 55438	PERMIT NO. 41644
55439	41645
54967	41314

IN NAME OF

BOEING AGRI-INDUSTRIAL CO.

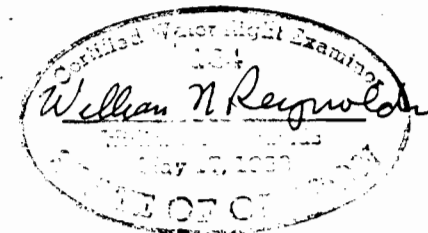

T-7541