

WATER RIGHT CLAIM OF BENEFICIAL USE MAP

MILL CREEK WATER RIGHT TRANSFER NO. 7509


LOCATED IN
SECTION 26, T. 14 S., R. 17 E., W.M.
CROOK COUNTY, OREGON

RECEIVED

MAY 23 2007

WATER RESOURCES DEPT
SALEM, OREGON

ALL OF SECTION 26 IS TAX LOT 2602
EXCEPT THE NW 1/4 OF THE SE 1/4 AS SHOWN HEREON.

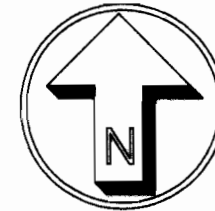

SCALE: 1" = 1320'

= MILL CREEK WATER RIGHT CERT. NO. 51178
113.0 ACRES


= MILL CREEK WATER RIGHT CERT. NO. 588
60.0 ACRES

COBU MAP # 0264


1 of 2

I, ROBERT E. BAXTER, CERTIFIED WATER RIGHT EXAMINER
IN THE STATE OF OREGON, HEREBY CERTIFY THAT THIS
WATER RIGHT SURVEY MAP WAS PREPARED BY ME.

THE PREPARATION OF THIS MAP IS FOR THE PURPOSE
OF IDENTIFYING THE LOCATION OF THE WATER RIGHT
ONLY AND HAS NO INTENT TO PROVIDE DIMENSIONS OR
LOCATIONS OF PROPERTY OWNERSHIP LINES.

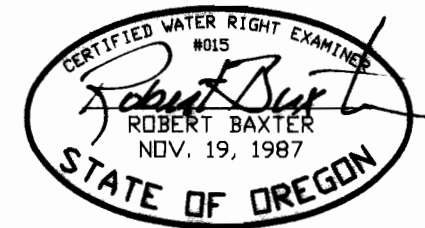

P.O.D. FROM MILL CREEK
1122 FT. NORTH AND
346 FT. WEST OF
THE NORTHWEST CORNER
OF SECTION 26

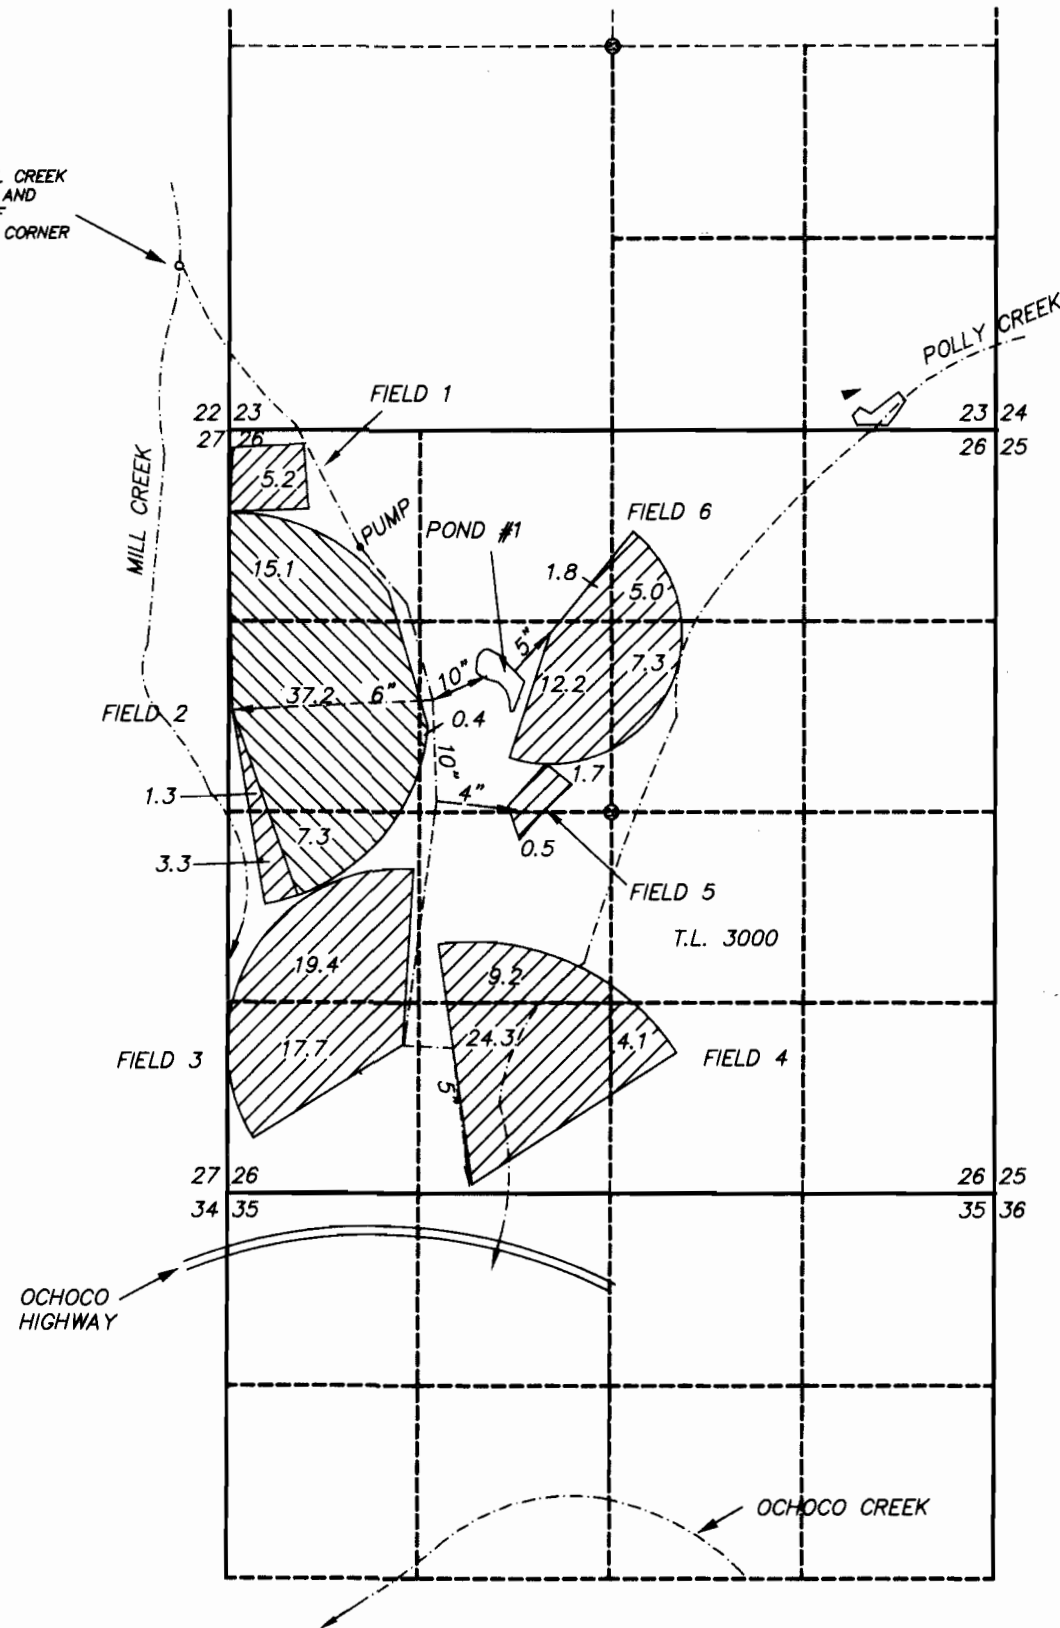

PREPARED BY
BAXTER LAND SURVEYING, INC.
20370 EMPIRE AVE. SUITE C3
BEND, ORE. 97701 (541) 382-1962

CLAIM OF BENEFICIAL USE MAP
FOR
MILL CREEK LAND, LLC

PREPARED FOR: MILL CREEK LAND, LLC
7900 NE MILL CREEK ROAD
PRINEVILLE, OREGON 97754
SCALE: 1" = 1320'
DATE: 5/21/07

SHEET 1 OF 2

WATER RIGHT CLAIM OF BENEFICIAL USE MAP

RECEIVED


MAY 23 2007

WATER RESOURCES DEPT
SALEM, OREGON

OCHOCO CREEK WATER RIGHT TRANSFER 7509

LOCATED IN
SECTION 35, T. 14 S., R. 17 E., W.M.
CROOK COUNTY, OREGON


ORIGINAL CERTIFICATE NO. 602
SUPERSEDED BY CERTIFICATE NO. 55564
ORIGINAL P.O.D. SOUTH 450 FT. AND WEST 570 FT.
FROM THE N.E. CORNER OF THE SE 1/4, NW 1/4, SEC. 36

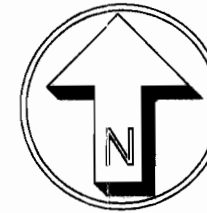

SCALE: 1" = 1320'

= OCHOCO CREEK WATER RIGHT
FINAL LOCATION

MARK COPELAND = 14.8 AC.
DENNIS DICE = 25.2 AC.

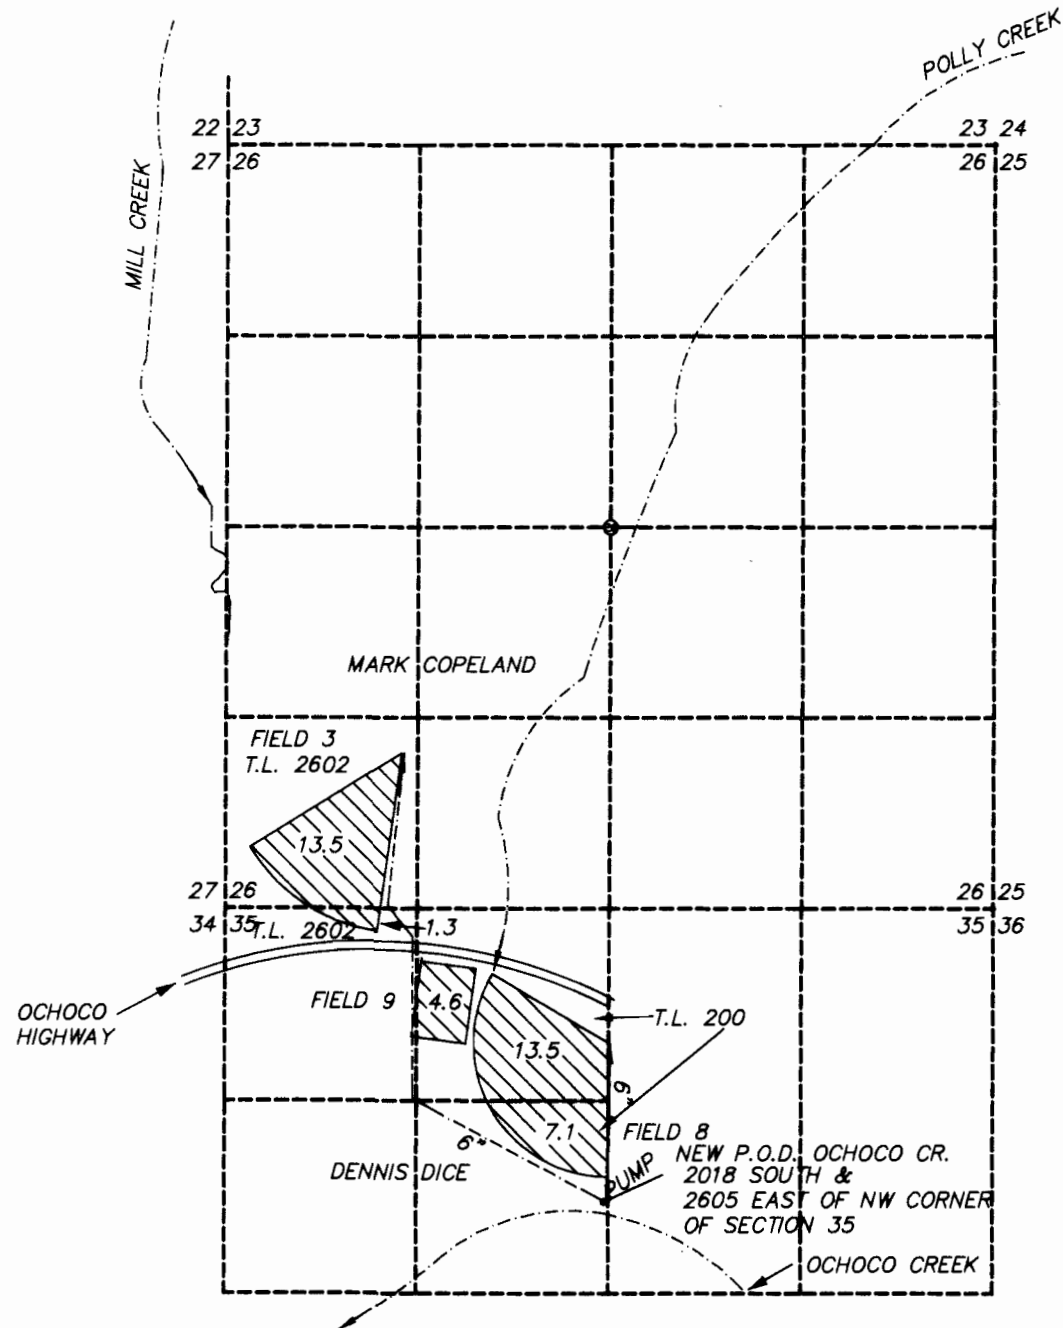


COBU MAP # 0264

2 of 2

I, ROBERT E. BAXTER, CERTIFIED WATER RIGHT EXAMINER
IN THE STATE OF OREGON, HEREBY CERTIFY THAT THIS
WATER RIGHT SURVEY MAP WAS PREPARED BY ME.

THE PREPARATION OF THIS MAP IS FOR THE PURPOSE
OF IDENTIFYING THE LOCATION OF THE WATER RIGHT
ONLY AND HAS NO INTENT TO PROVIDE DIMENSIONS OR
LOCATIONS OF PROPERTY OWNERSHIP LINES.

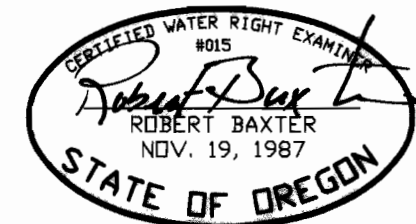

PREPARED BY
BAXTER LAND SURVEYING, INC.
20370 EMPIRE AVE. SUITE C3
BEND, ORE. 97701 (541) 382-1962

CLAIM OF BENEFICIAL USE MAP
FOR
MILL CREEK LAND, LLC & DENNIS DICE

PREPARED FOR: MILL CREEK LAND, LLC
7900 NE MILL CREEK ROAD
PRINEVILLE, OREGON 97754
SCALE: 1" = 1320'
DATE: 5/21/07

SHEET 2 OF 2