

# FINAL PROOF SURVEY AND CLAIM OF BENEFICIAL USE


LOCATED IN

NW 1/4, SE 1/4, NW 1/4 SECTION 10, T.4N., R.29E., W.M.  
UMATILLA COUNTY, OREGON


APPLICANTS: ROBERT C. AND VIRGINIA L. FRANKLIN  
TRANSFER 8232 SPECIAL ORDER V.53, P. 696  
A PORTION OF PERMIT G-5451

NEW POINT OF  
APPROPRIATION.  
A WELL 3,651 FEET  
NORTH AND 1,492  
FEET EAST OF  
SECTION CORNER 9,  
10, 15 & 16, T.4N.,  
R.29E., W.M.

NW 1/4  
SE 1/4  
NW 1/4

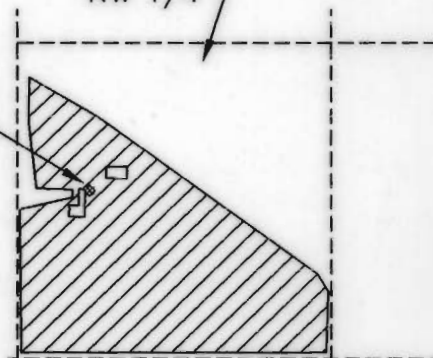

GRAPHIC SCALE

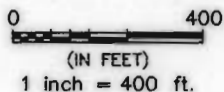

**LEGEND**

⊙ WELL

----- 1/64TH LINE

AREA UNDER IRRIGATION  
5.20 ACRES

**RECEIVED**

**SEP 03 1999**

**WATER RESOURCES DEPT.  
SALEM, OREGON**

This map is prepared for the express purpose to show water appropriation and use. It is not intended to show or locate property ownership lines.



DENNIS L. GAYLORD, CWRE  
71614 S.W. LAKE DRIVE  
PENDLETON, OR 97801  
(541) 276-6260  
August 14, 1999

DRAWN BY: H B WILLIAMS DRAFTING

©

Renews JUNE 30, 2001