


T.5S. R.1W. W.M.

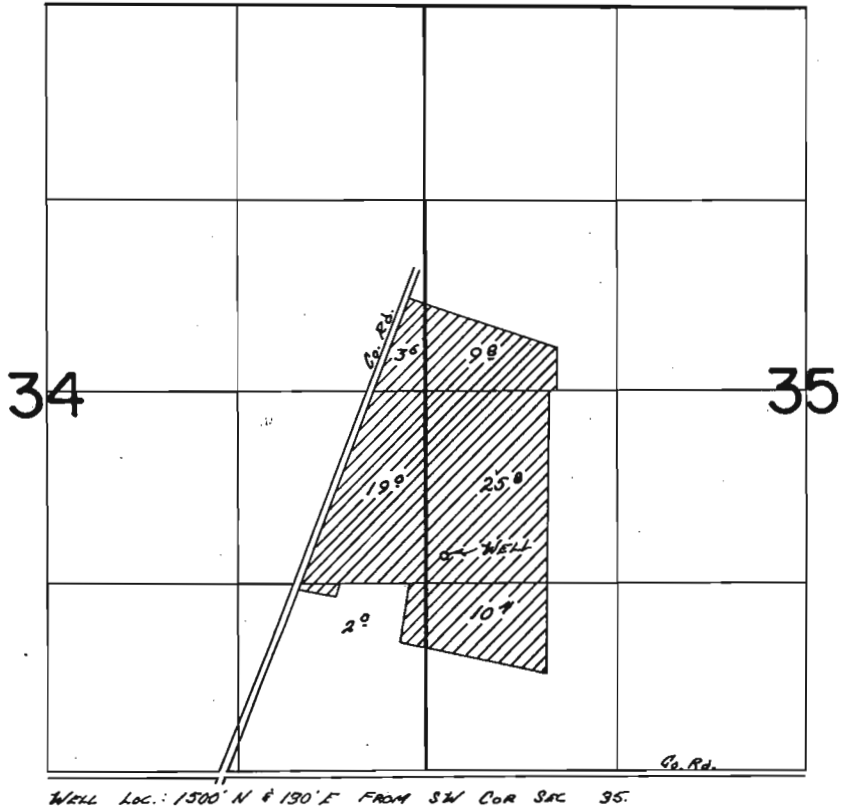

FINAL PROOF SURVEY UNDER

Application No. G-3973 Permit No. B-3730
IN NAME OF

JOE BOCHSLER

Surveyed May 21 1973, by T. J. Paul