


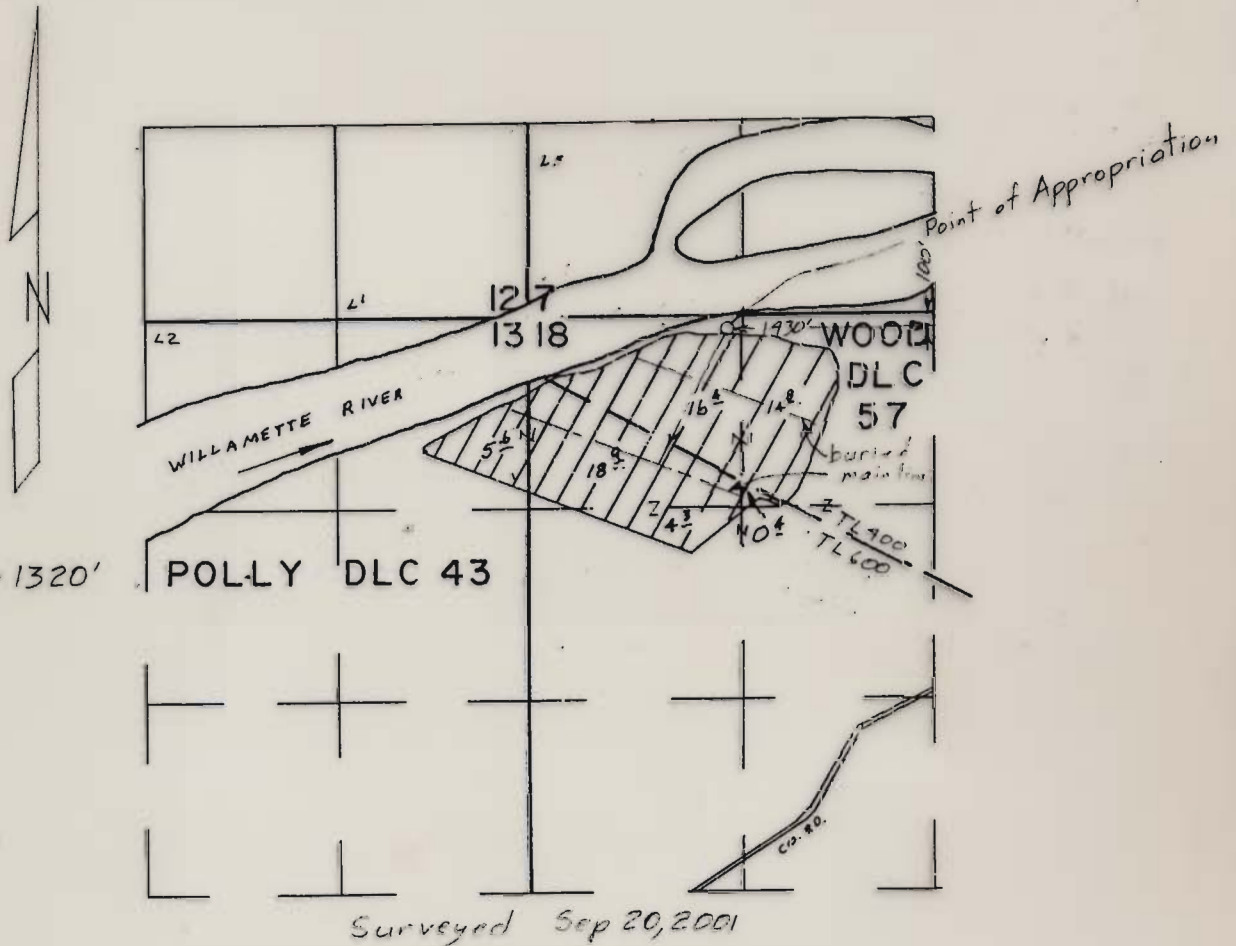


T.9S. R.3 & 4W. W.M.



Claim of Beneficial Use Map  
for  
CHARLES & ANDY KEESECKER

T-8245

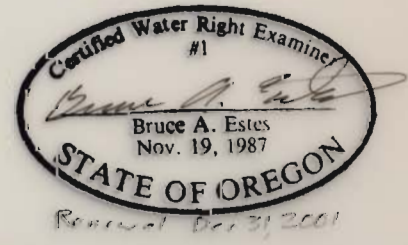

This map is for the purpose of locating a water right only and has no intent to provide legal dimensions or the location of property lines.

**ESTES SURVEYS, LLC**  
 6293 Sunnyview Rd. NE 60382 Arnold Rd.  
 Salem, OR 97305 Bend, OR 97702  
 (503) 585-7593 (503) 382-7391