

RECEIVED

APR 01 1999


WATER RESOURCES DEPT.  
SALEM, OREGON

RECEIVED

APR 8 1999

WATER RESOURCES DEPT.  
SALEM, OREGON

T.2S.R.9W.W.M.

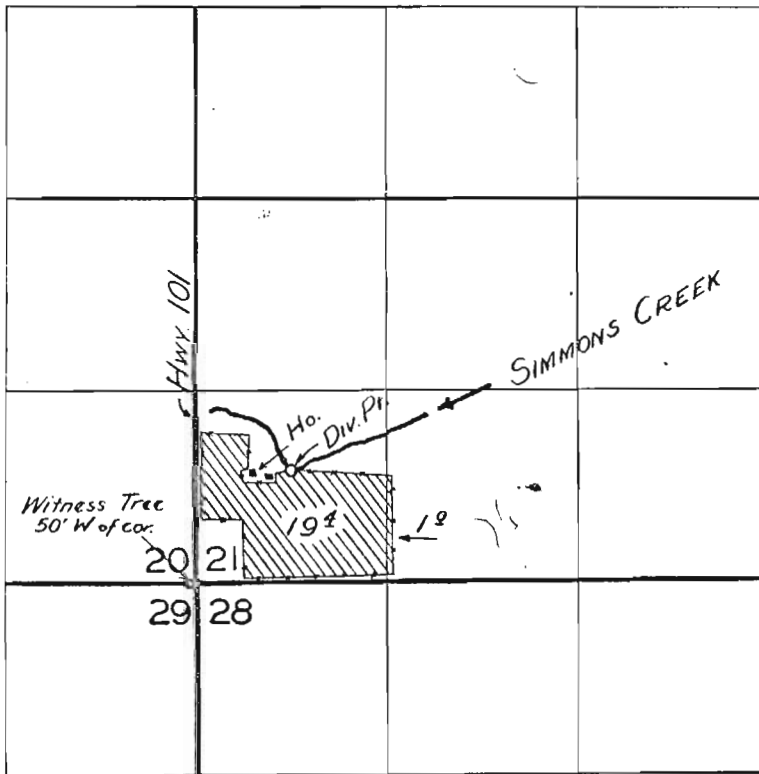

FINAL PROOF SURVEY

UNDER

Application No. 24761... Permit No. 19519...

IN NAME OF

*Frank Portman*

Surveyed 8 Aug. 1955, by

*[Signature]*