


T. 12 S. R. 2 & 3 W. W.M.

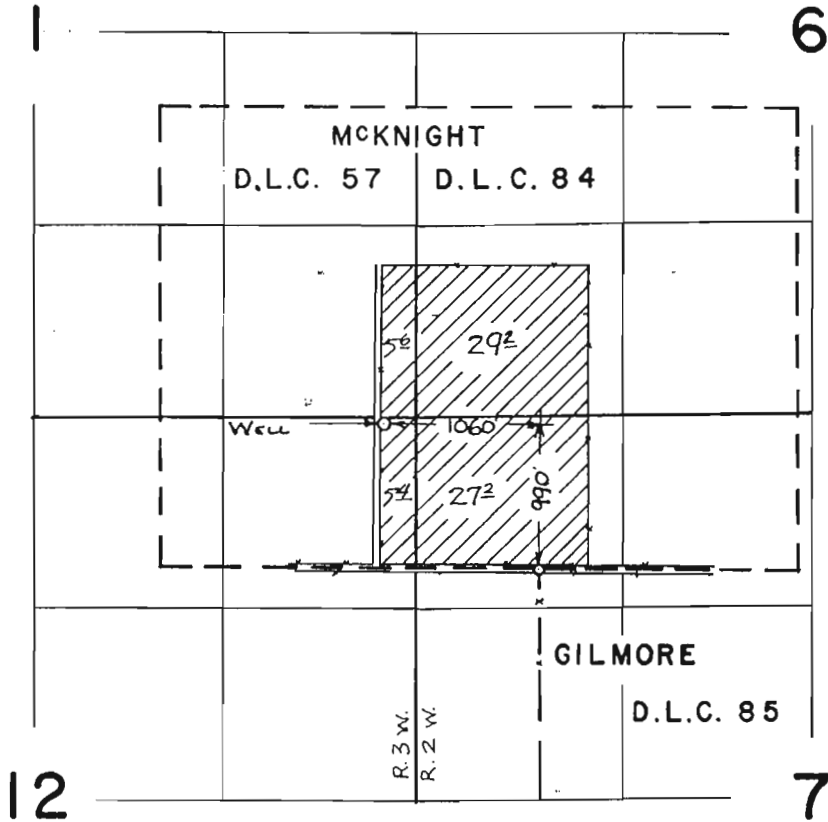

**FINAL PROOF SURVEY**  
UNDER

Application No. G. 2566. Permit No. G. 2375.  
IN NAME OF

GLENN L. JACKSON

Surveyed 18 AUG. 1969, by W. J. RUPPERT