



RECEIVED

NOV - 5 1996

WATER RESOURCES DEPT.  
SALEM, OREGON

# ANDERSON LAND & LIVESTOCK PERMIT G-6142 CERTIFICATE 53737 TRANSFER FROM SUPPLEMENTAL IRRIGATION TO PRIMARY IRRIGATION T. 4N., R. 29E., W.M.

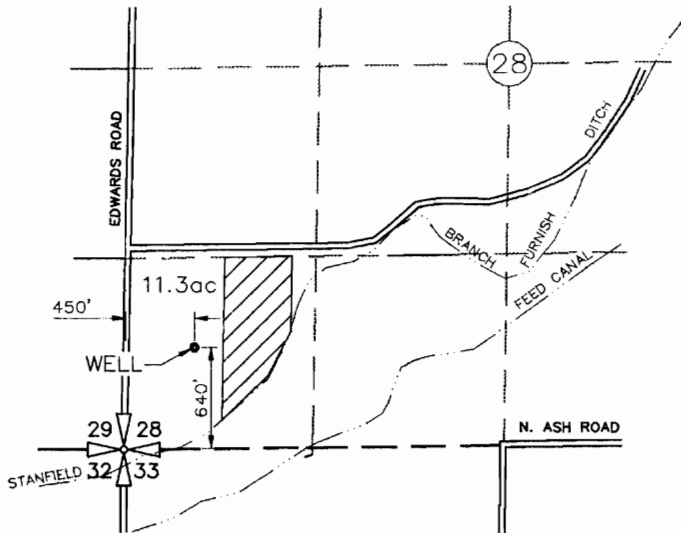

 AREA TO BE TRANSFERRED



*Robert J. Van der Horst*

*10/10/96*

**NOTE:** INFORMATION ON THIS MAP HAS BEEN PREPARED USING EXISTING MAPS AND OTHER INFORMATION MADE AVAILABLE BY THE OWNERS AND INFORMATION OBTAINED IN THE FIELD WHERE AVAILABLE. SCM MAKES NO CERTIFICATION AS TO ITS ACCURACY.

*T 7650*