
## TOWNSHIP 5 SOUTH, RANGE I WEST, W. M. WATER PESOLUTION OREGON DEPT

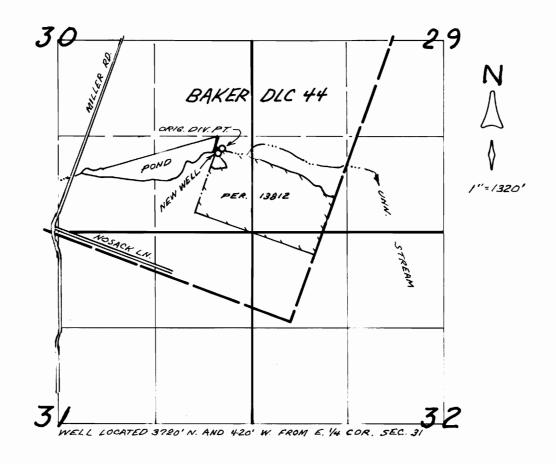

FINAL PROOF SURVEY

UNDER

TRANSFER NO. 7659

IN NAME OF

EDER FARMS, INC.

Aug. 16, 1999



THIS MAP WAS PREPARED FOR THE PURPOSE OF IDENTIFYING THE LOCATION OF A WATER RIGHT ONLY AND IS NOT INTENDED TO PROVIDE LEGAL DIMENSIONS OR LOCATION OF PROPERTY OWNERSHIP LINES.