


RECEIVED

10/10/2000

WATER RIGHTS
S. REGION

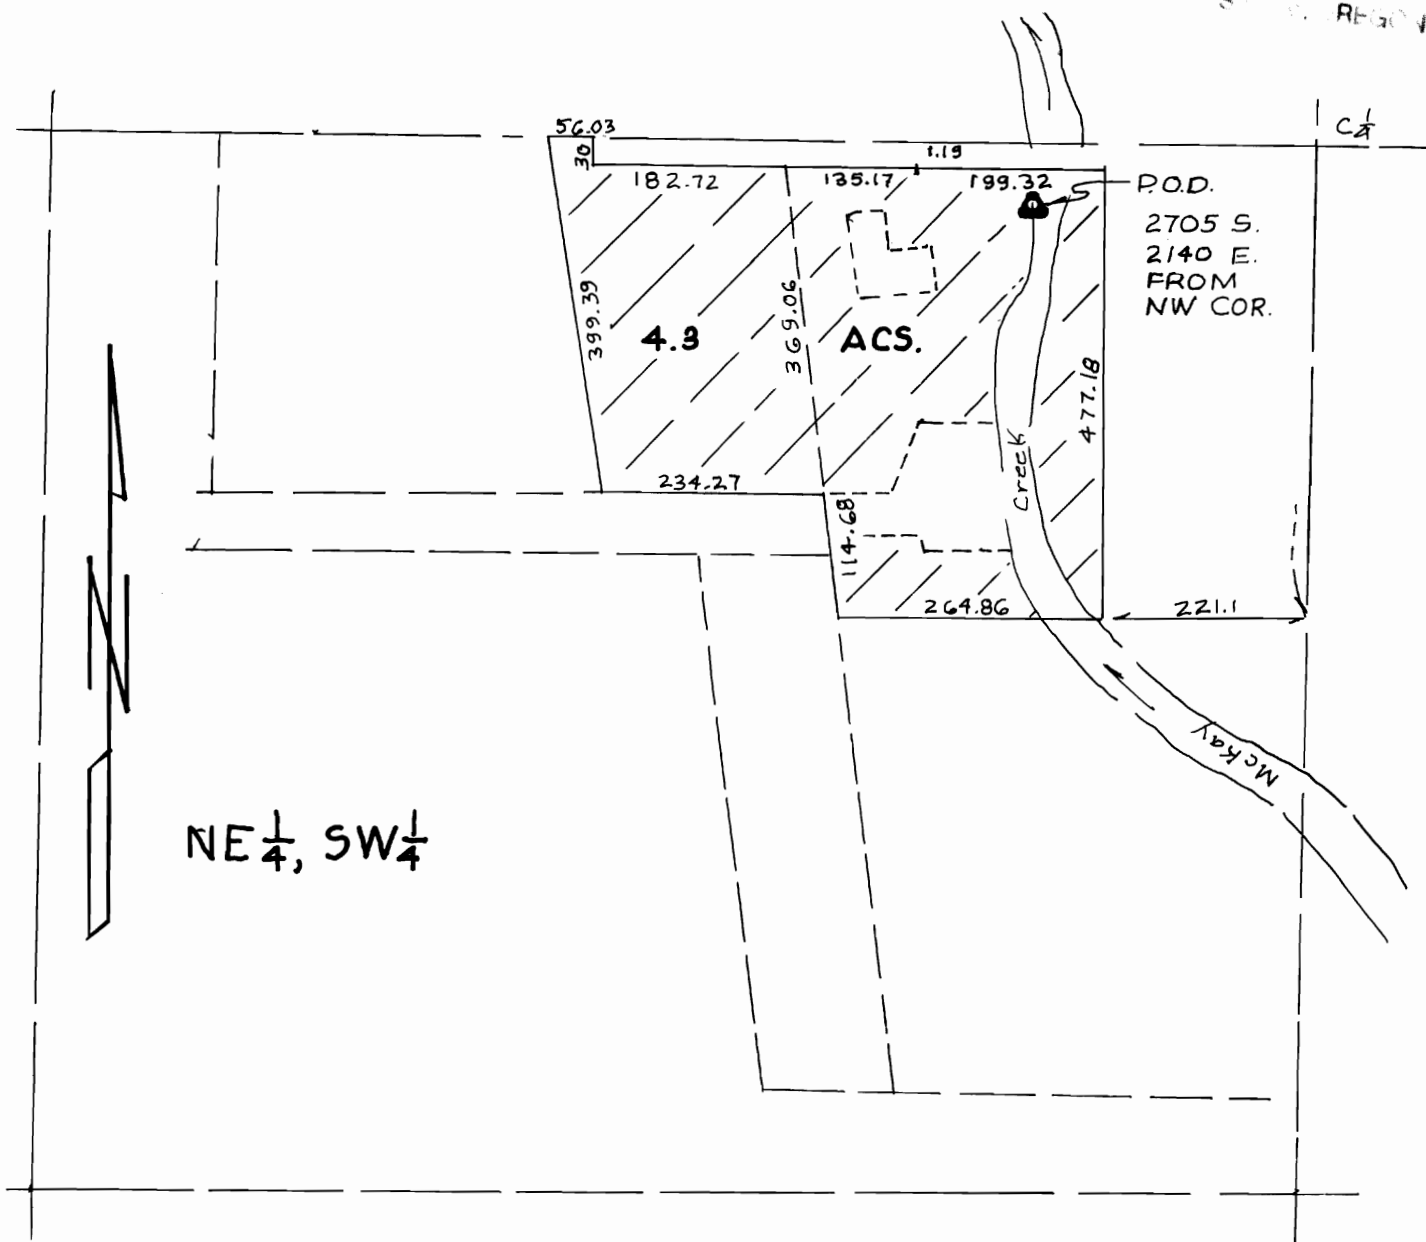

K **KRUMBEIN ENGINEERING LTD.**
ENGINEERS — SURVEYORS — PLANNERS
361 S.E. Second Pendleton, Oregon

Scale
1" = 200'

Drn. By
DHK

Drng. No.
0032A

Revision 1

Date
9-27-00

Ckd. By

Job No.
9951

Revision 2


FINAL PROOF MAP

LONGGOOD

NE $\frac{1}{4}$, SW $\frac{1}{4}$, SECTION 21

T. 2 N., R. 32 E. W. M.

UMATILLA COUNTY, OR.

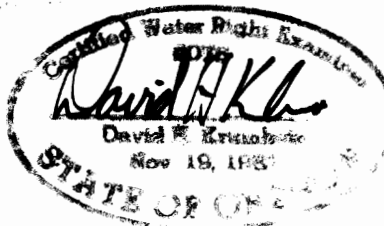

T-7665

RENEWS 6/30/01