


Township 5 South, Range 1 West, W. M.

Section 35

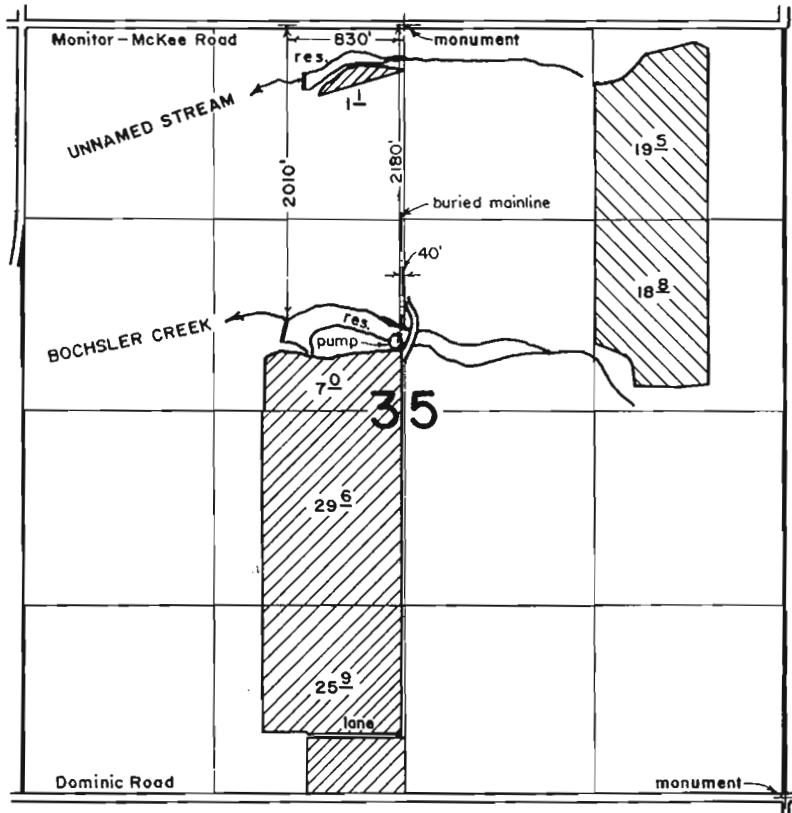


PRIMARY 
 SUPPLEMENTAL 

RECEIVED

MAY - 2 1996

WATER RESOURCES DE
 SALEM, OREGON

FINAL PROOF SURVEY
 under
 Appl. No. 70390, Per. No. 51434
 in name of
RON VANDECOEVERING
 Jan. 23, 1996

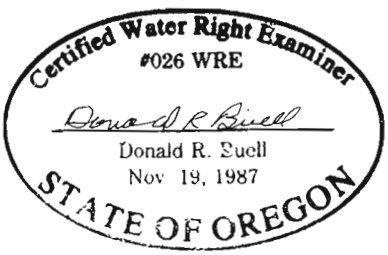

THIS MAP WAS PREPARED FOR THE PURPOSE OF IDENTIFYING THE LOCATION OF A WATER RIGHT ONLY AND IS NOT INTENDED TO PROVIDE LEGAL DIMENSIONS OR LOCATION OF PROPERTY OWNERSHIP LINES.