


TOWNSHIP 2 SOUTH, RANGE 3 EAST, W.M.

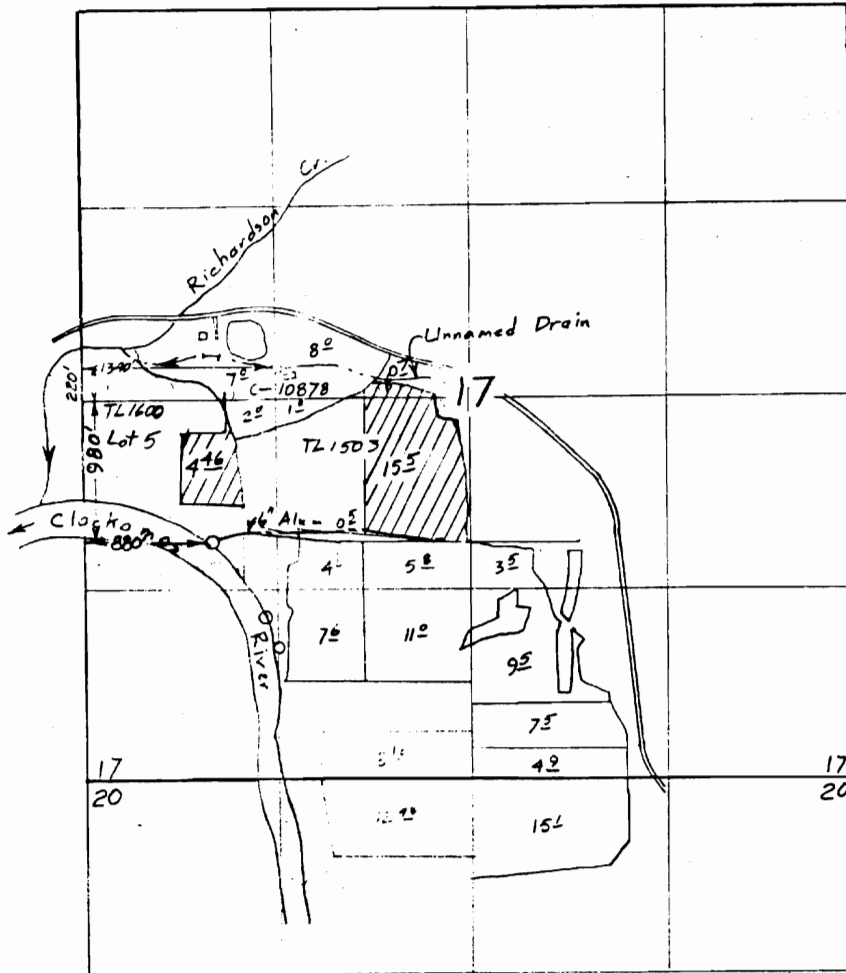


Scale 1" = 1320'

Surveyed Sep 18, 2000 .

T-7676

Claim of Beneficial Use Map
for
JIM CALCAGNO

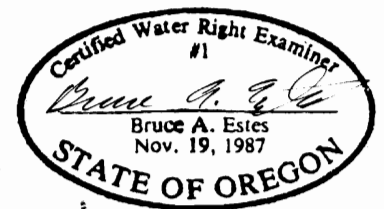

This map is for the purpose of locating a water right only and has no intent to provide legal dimensions or the location of property lines.

ESTES SURVEYS
 6293 Sunnyview Rd. NE Salem, OR 97305 (503) 585-7593
 60382 Arnold Rd. Bend, OR 97702 (503) 382-7391