


also see # 27

71-101
8

RECEIVED

JAN 24 1997
WATER RESOURCES DEPT.
SALEM, OREGON

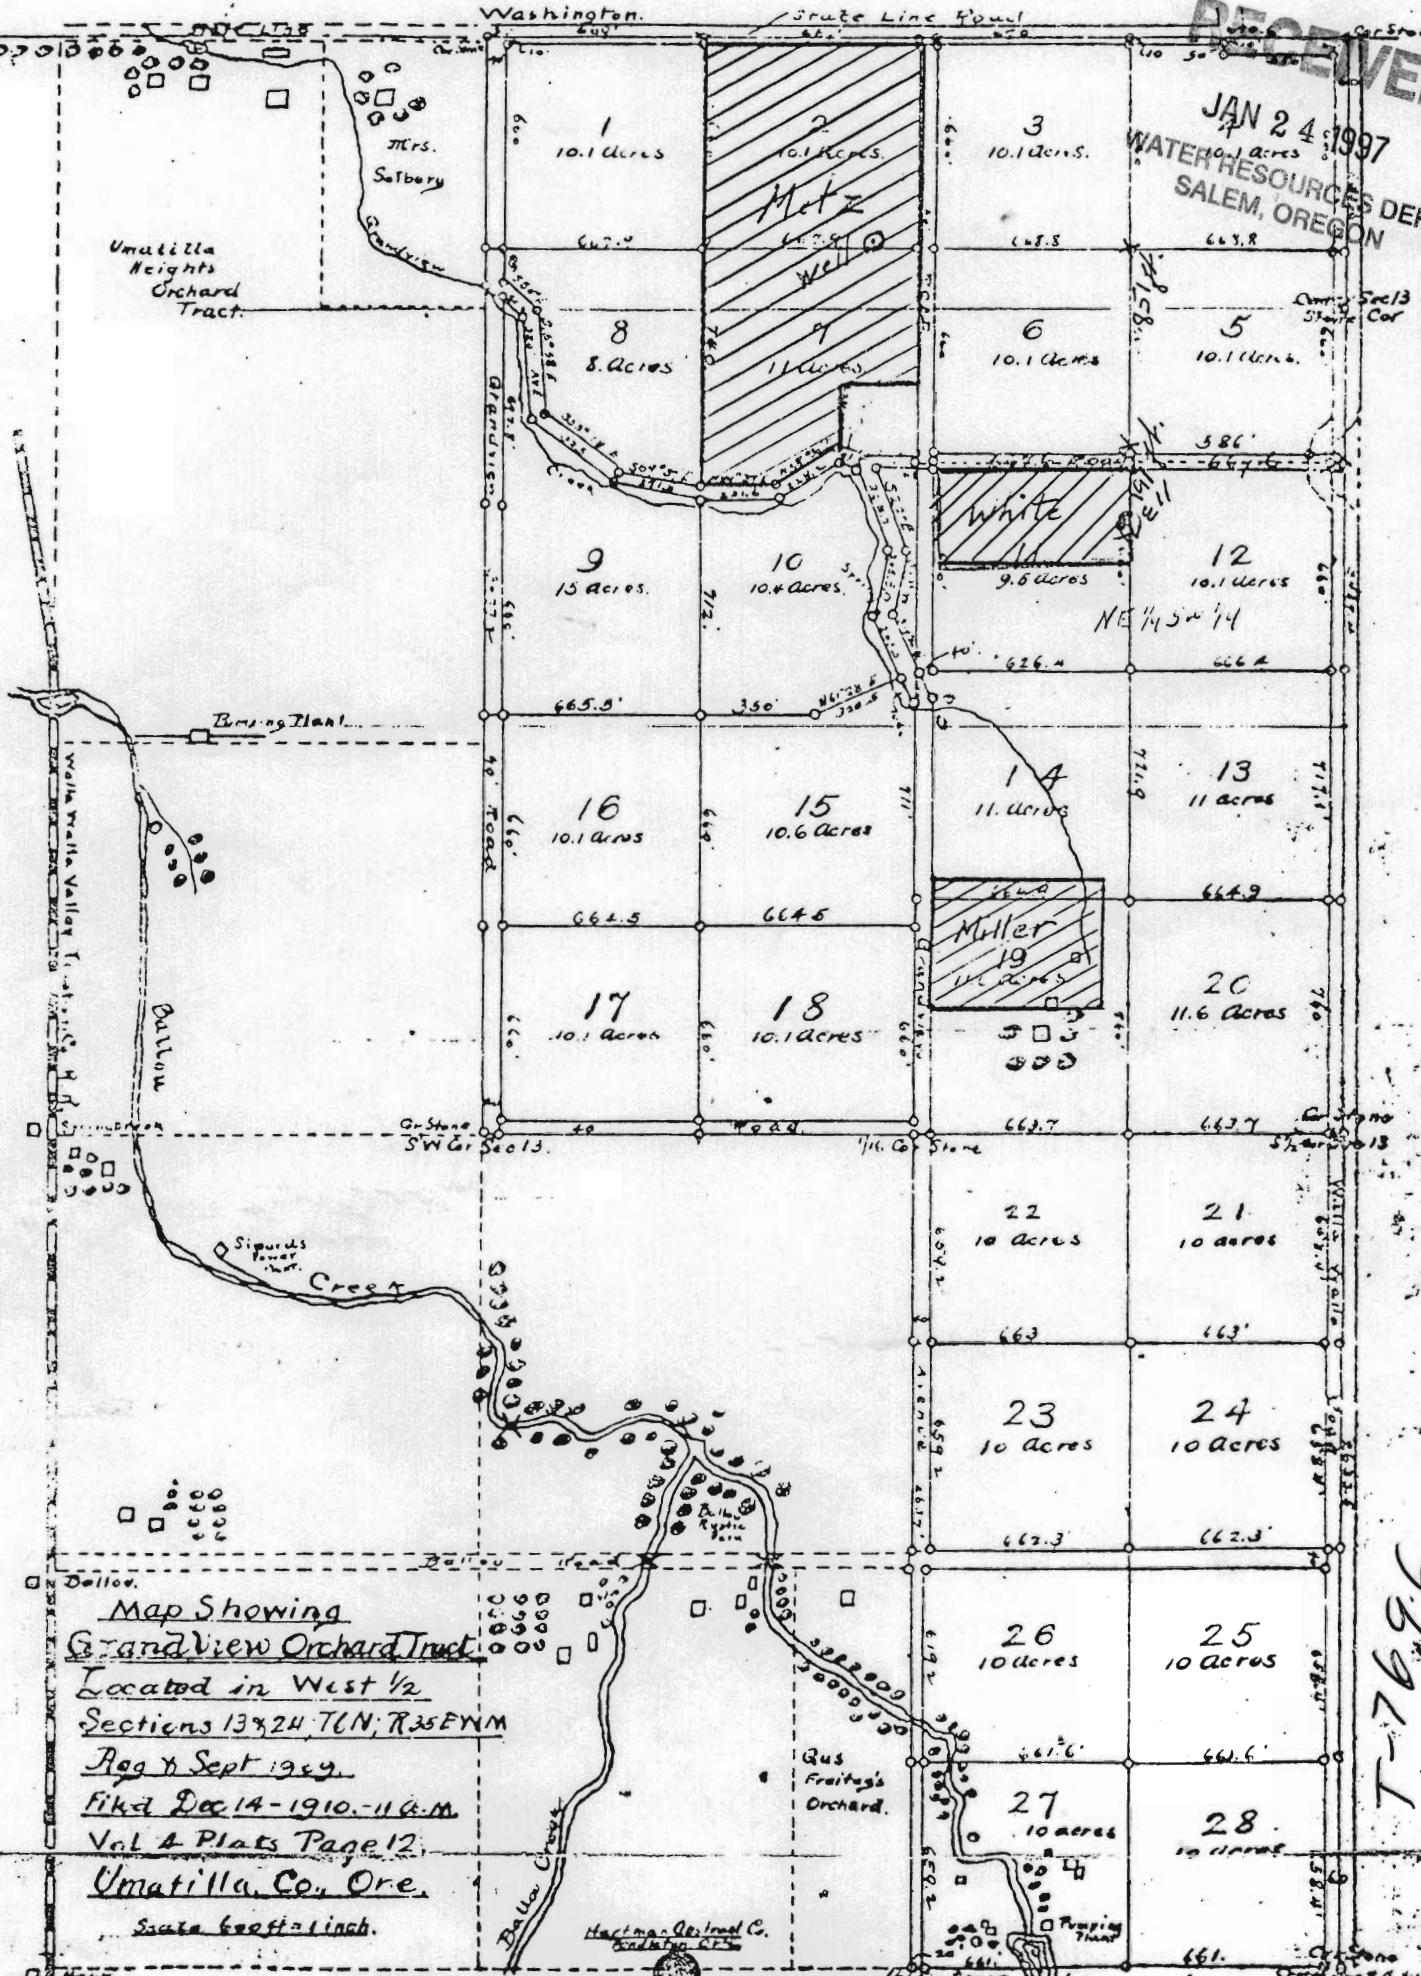

Map Showing
 Grand View Orchard Tract
 Located in West 1/2
 Sections 13, 24, T6N, R35E, W4M
 App'd Sept 1929
 Filed Dec 14-1910-11 A.M.
 Vol 4 Plats Page 12
 Umatilla Co., Ore.
 Scale 600ft = 1 inch.

T-7696