


T. 4 S. R. 4 W. W.M.

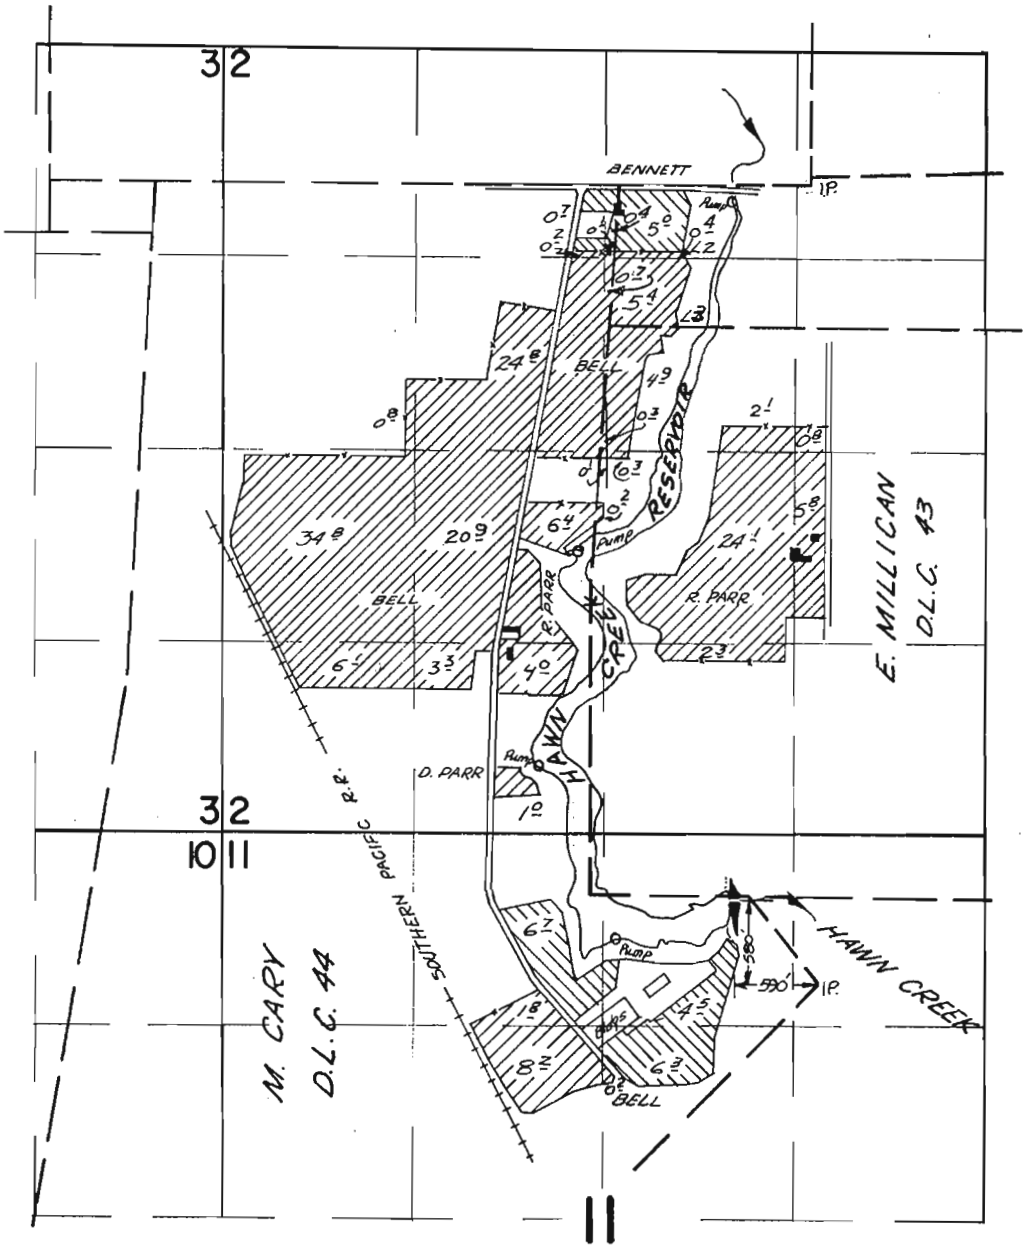

FINAL PROOF SURVEY UNDER

Supp.
 Primary

R 34388 R 2570
 Application No. 34389 Permit No. 27097
 IN NAME OF


Surveyed April 12, 1967, by V. GARNER