


WATER RIGHT MAP

application # 13505

Permit G12307

FOR: LEONARD BIZON
RT. 1, BOX 429
HUBBARD, ORE.

TOWNSHIP 4 SOUTH, RANGE 1 WEST, W.M. - SECTIONS 31 & 32

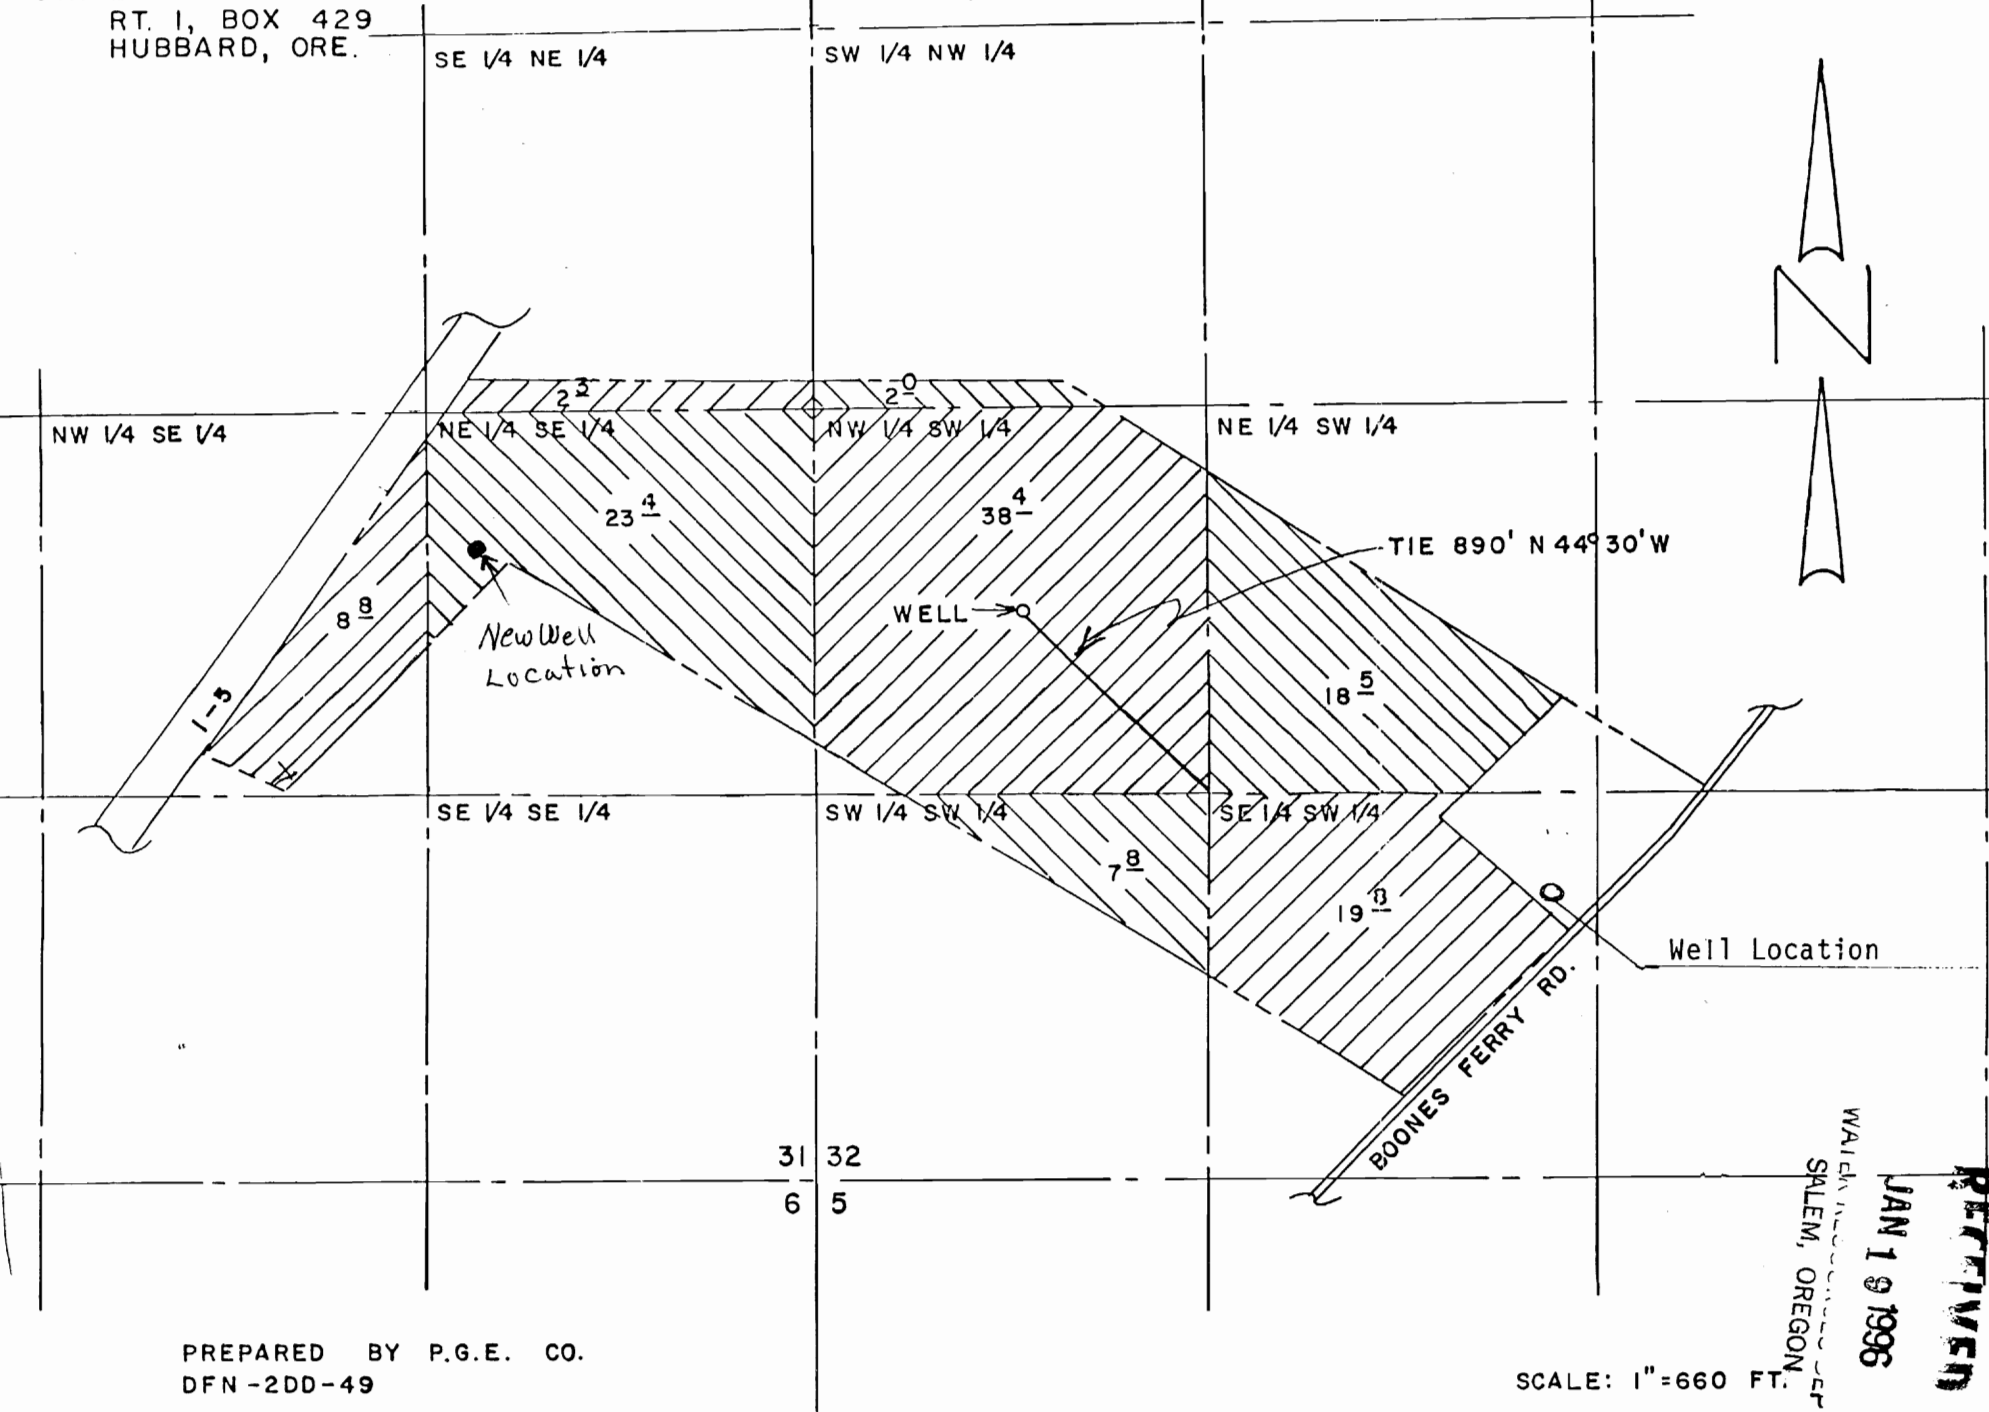

PREPARED BY P.G.E. CO.
DFN-2DD-49

SCALE: 1" = 660 FT.

JAN 19 1996
SALEM, OREGON