


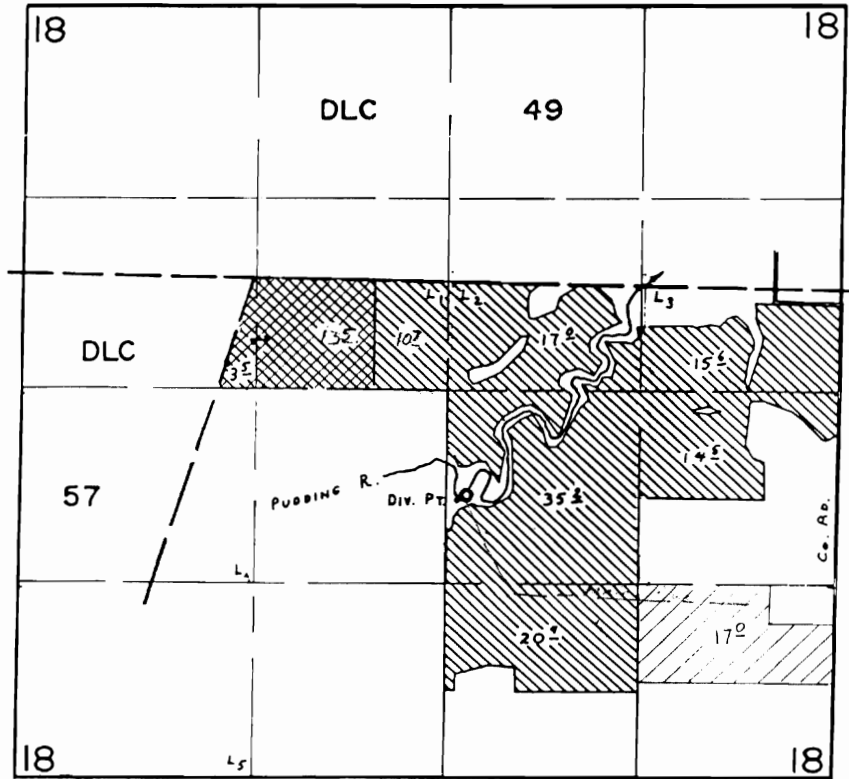


RECEIVED

APR 07 1997

WATER RESOURCES DEPT
SALEM, OREGON


T7S RIW WM



-  C-51933 To remain in place
-  C-51933 From (172)
-  To (172)

Temporary Transfer Application
for
KING FARMS

T 7735

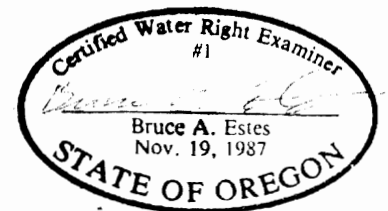

This map is for the purpose of locating a water right only and has no intent to provide legal dimensions or the location of property lines.

ESTES SURVEYS
 6293 Sunnyview Rd. NE 60382 Arnold Rd.
 Salem, OR 97305 Bend, OR 97702
 (503) 585-7593 (503) 382-7391