
## TOWNSHIP 5 SOUTH, RANGE I WEST, W.M.

PORTIONS OF SECTIONS 13,14,23 \$24

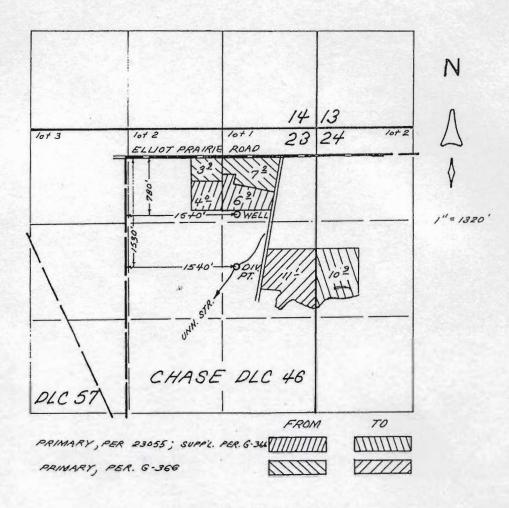

FINAL PROOF SURVEY

UNDER

TRANSFER 7/89

IN THE NAMES OF

MARVIN L. AND CHRISTINE B. RUFFING FEB. 4,1999



## RECEIVED

MAY 08 2007

THIS MAP WAS PREPARED FOR THE PURPOSE OF IDENTIFYING THE LOCATION OF A WATER RIGHT ONLY AND IS NOT INTENDED TO PROVIDE LEGAL DIMENSIONS OR LOCATION OF PROPERTY OWNERSHIP LINES.

WATER RESOURCES DEPT