


MEDFORD IRRIGATION DISTRICT
 1340 MYERS LANE
 MEDFORD OR 97501
 (541)779-1462

RECEIVED

NOV 14 1996

WATER RESOURCES DEPT.
 SALEM, OREGON

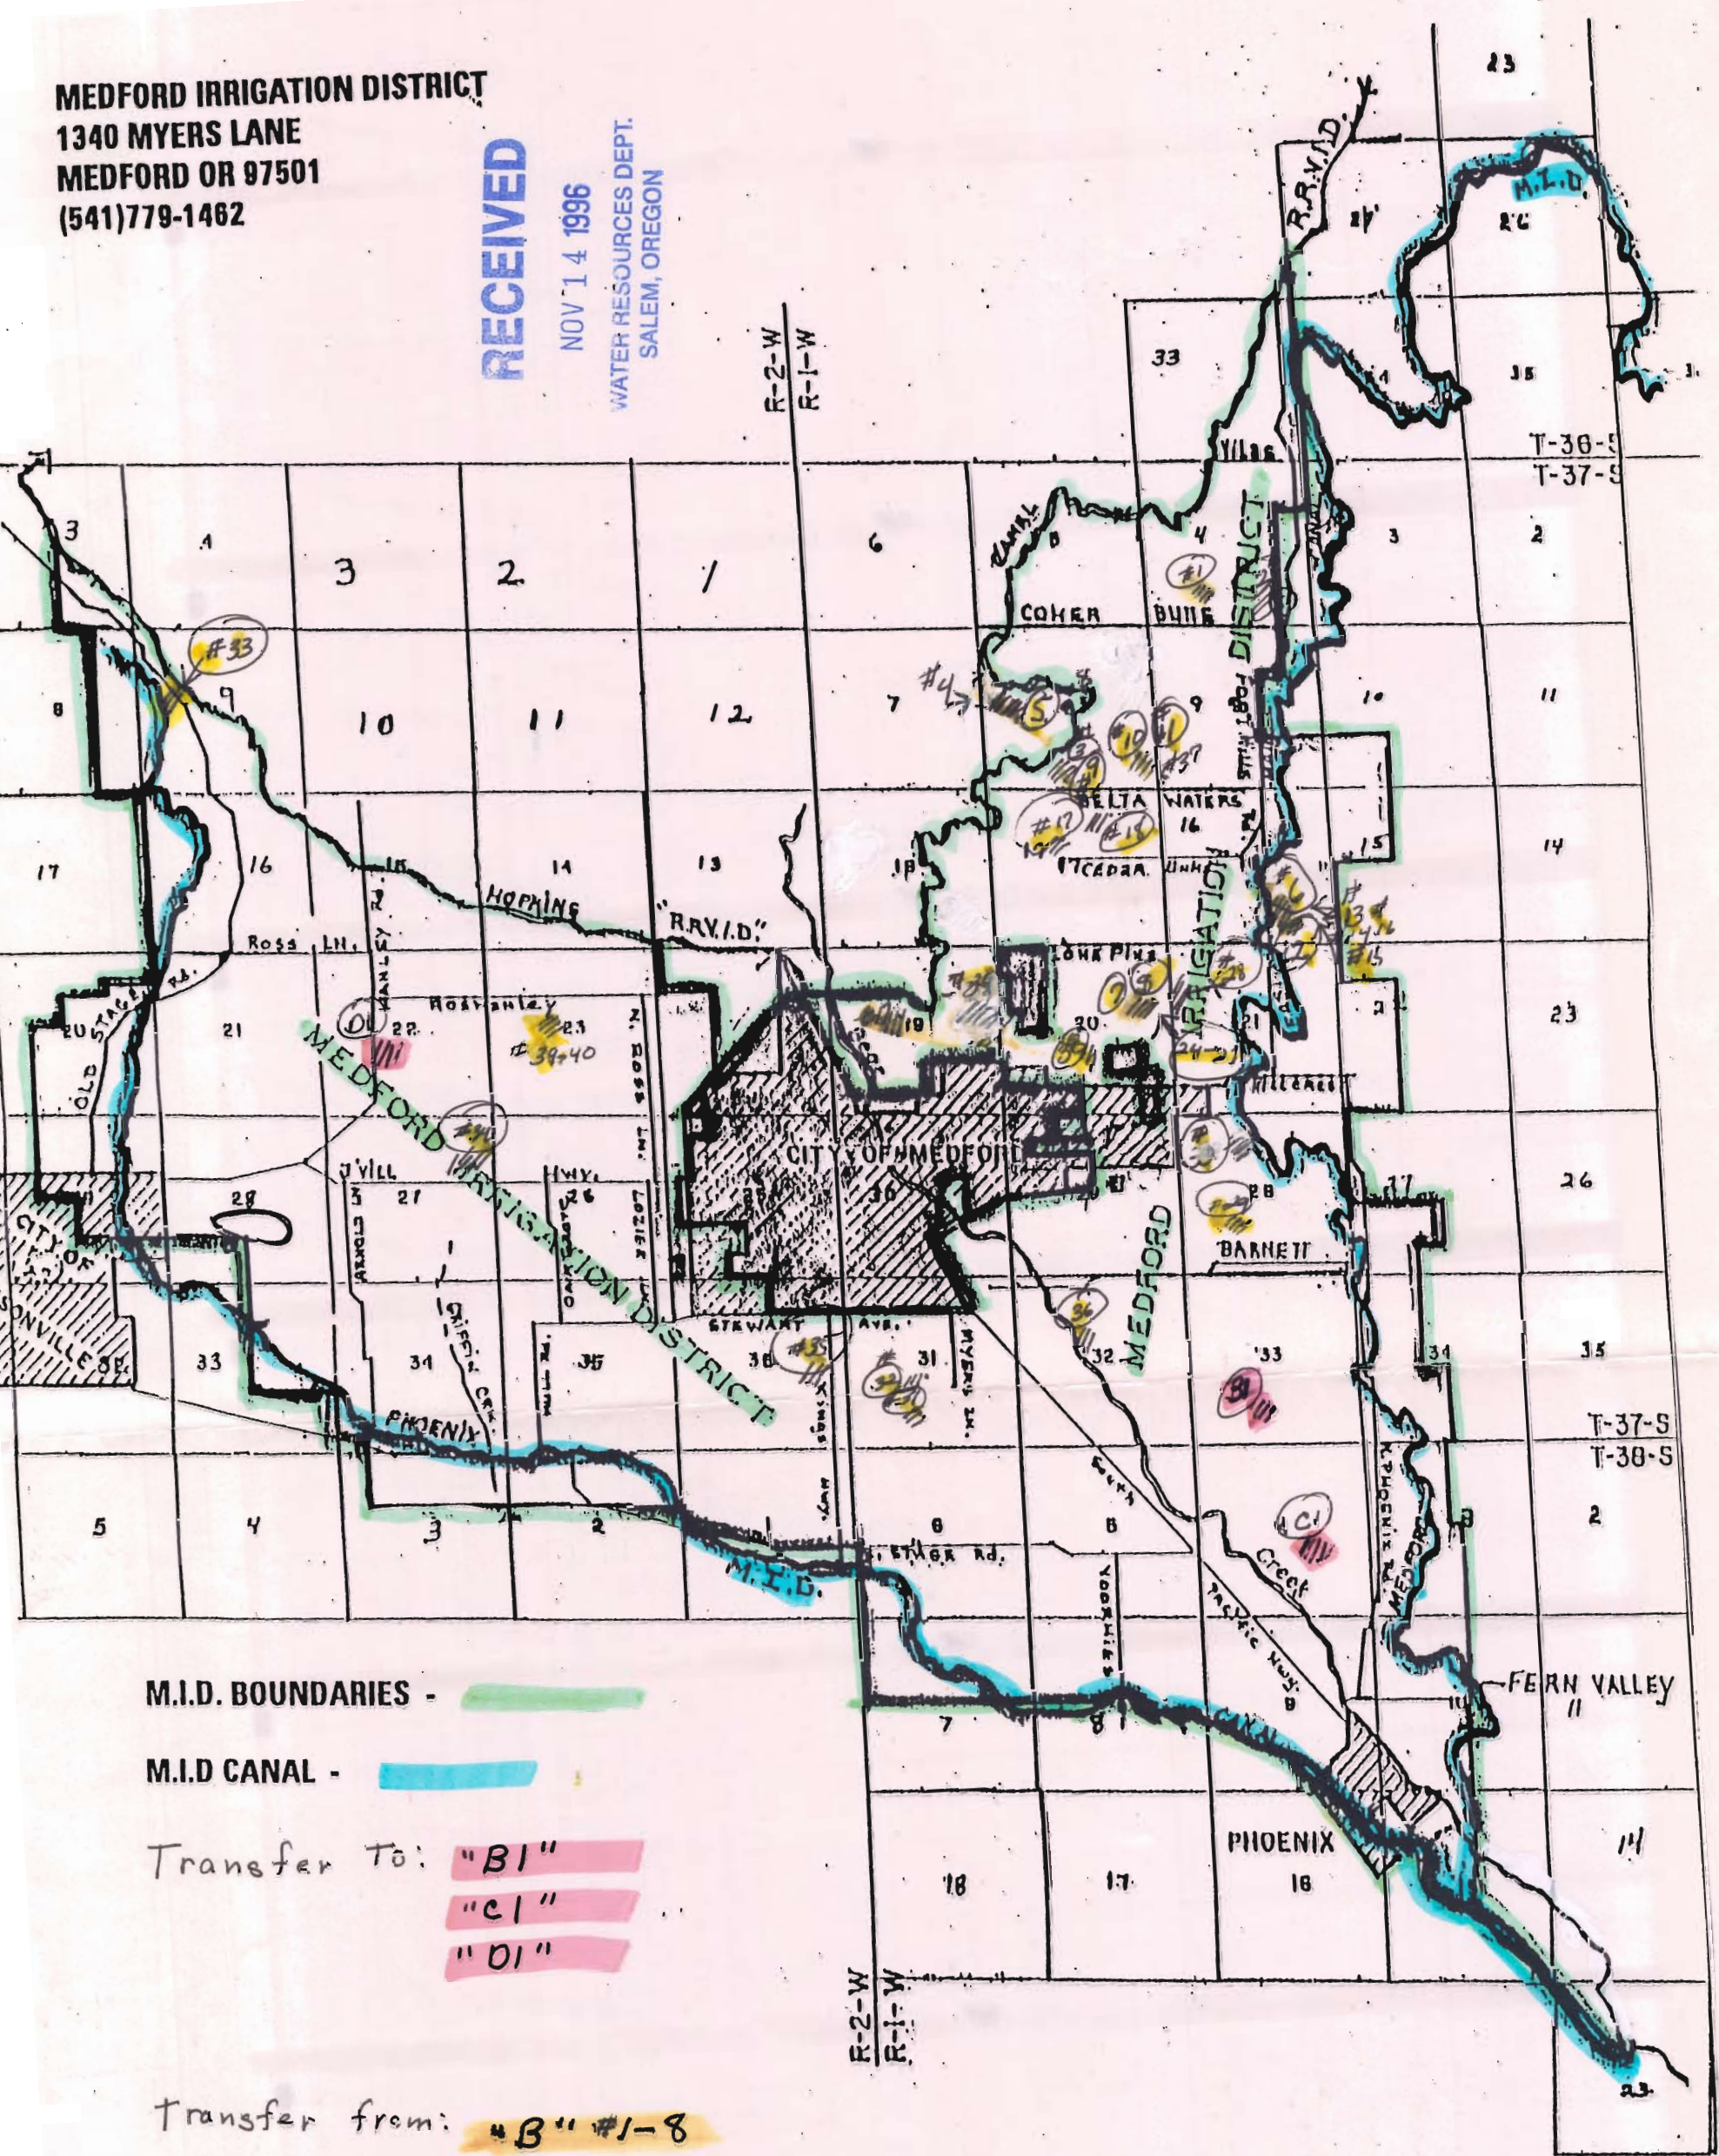

RECEIVED

NOV 14 1996

WATER RESOURCES DEPT.
 SALEM, OREGON

T7654