FINAL PROOF SURVEY
UNDER
APPLICATION No. T-7706

AUGUST 25,1999

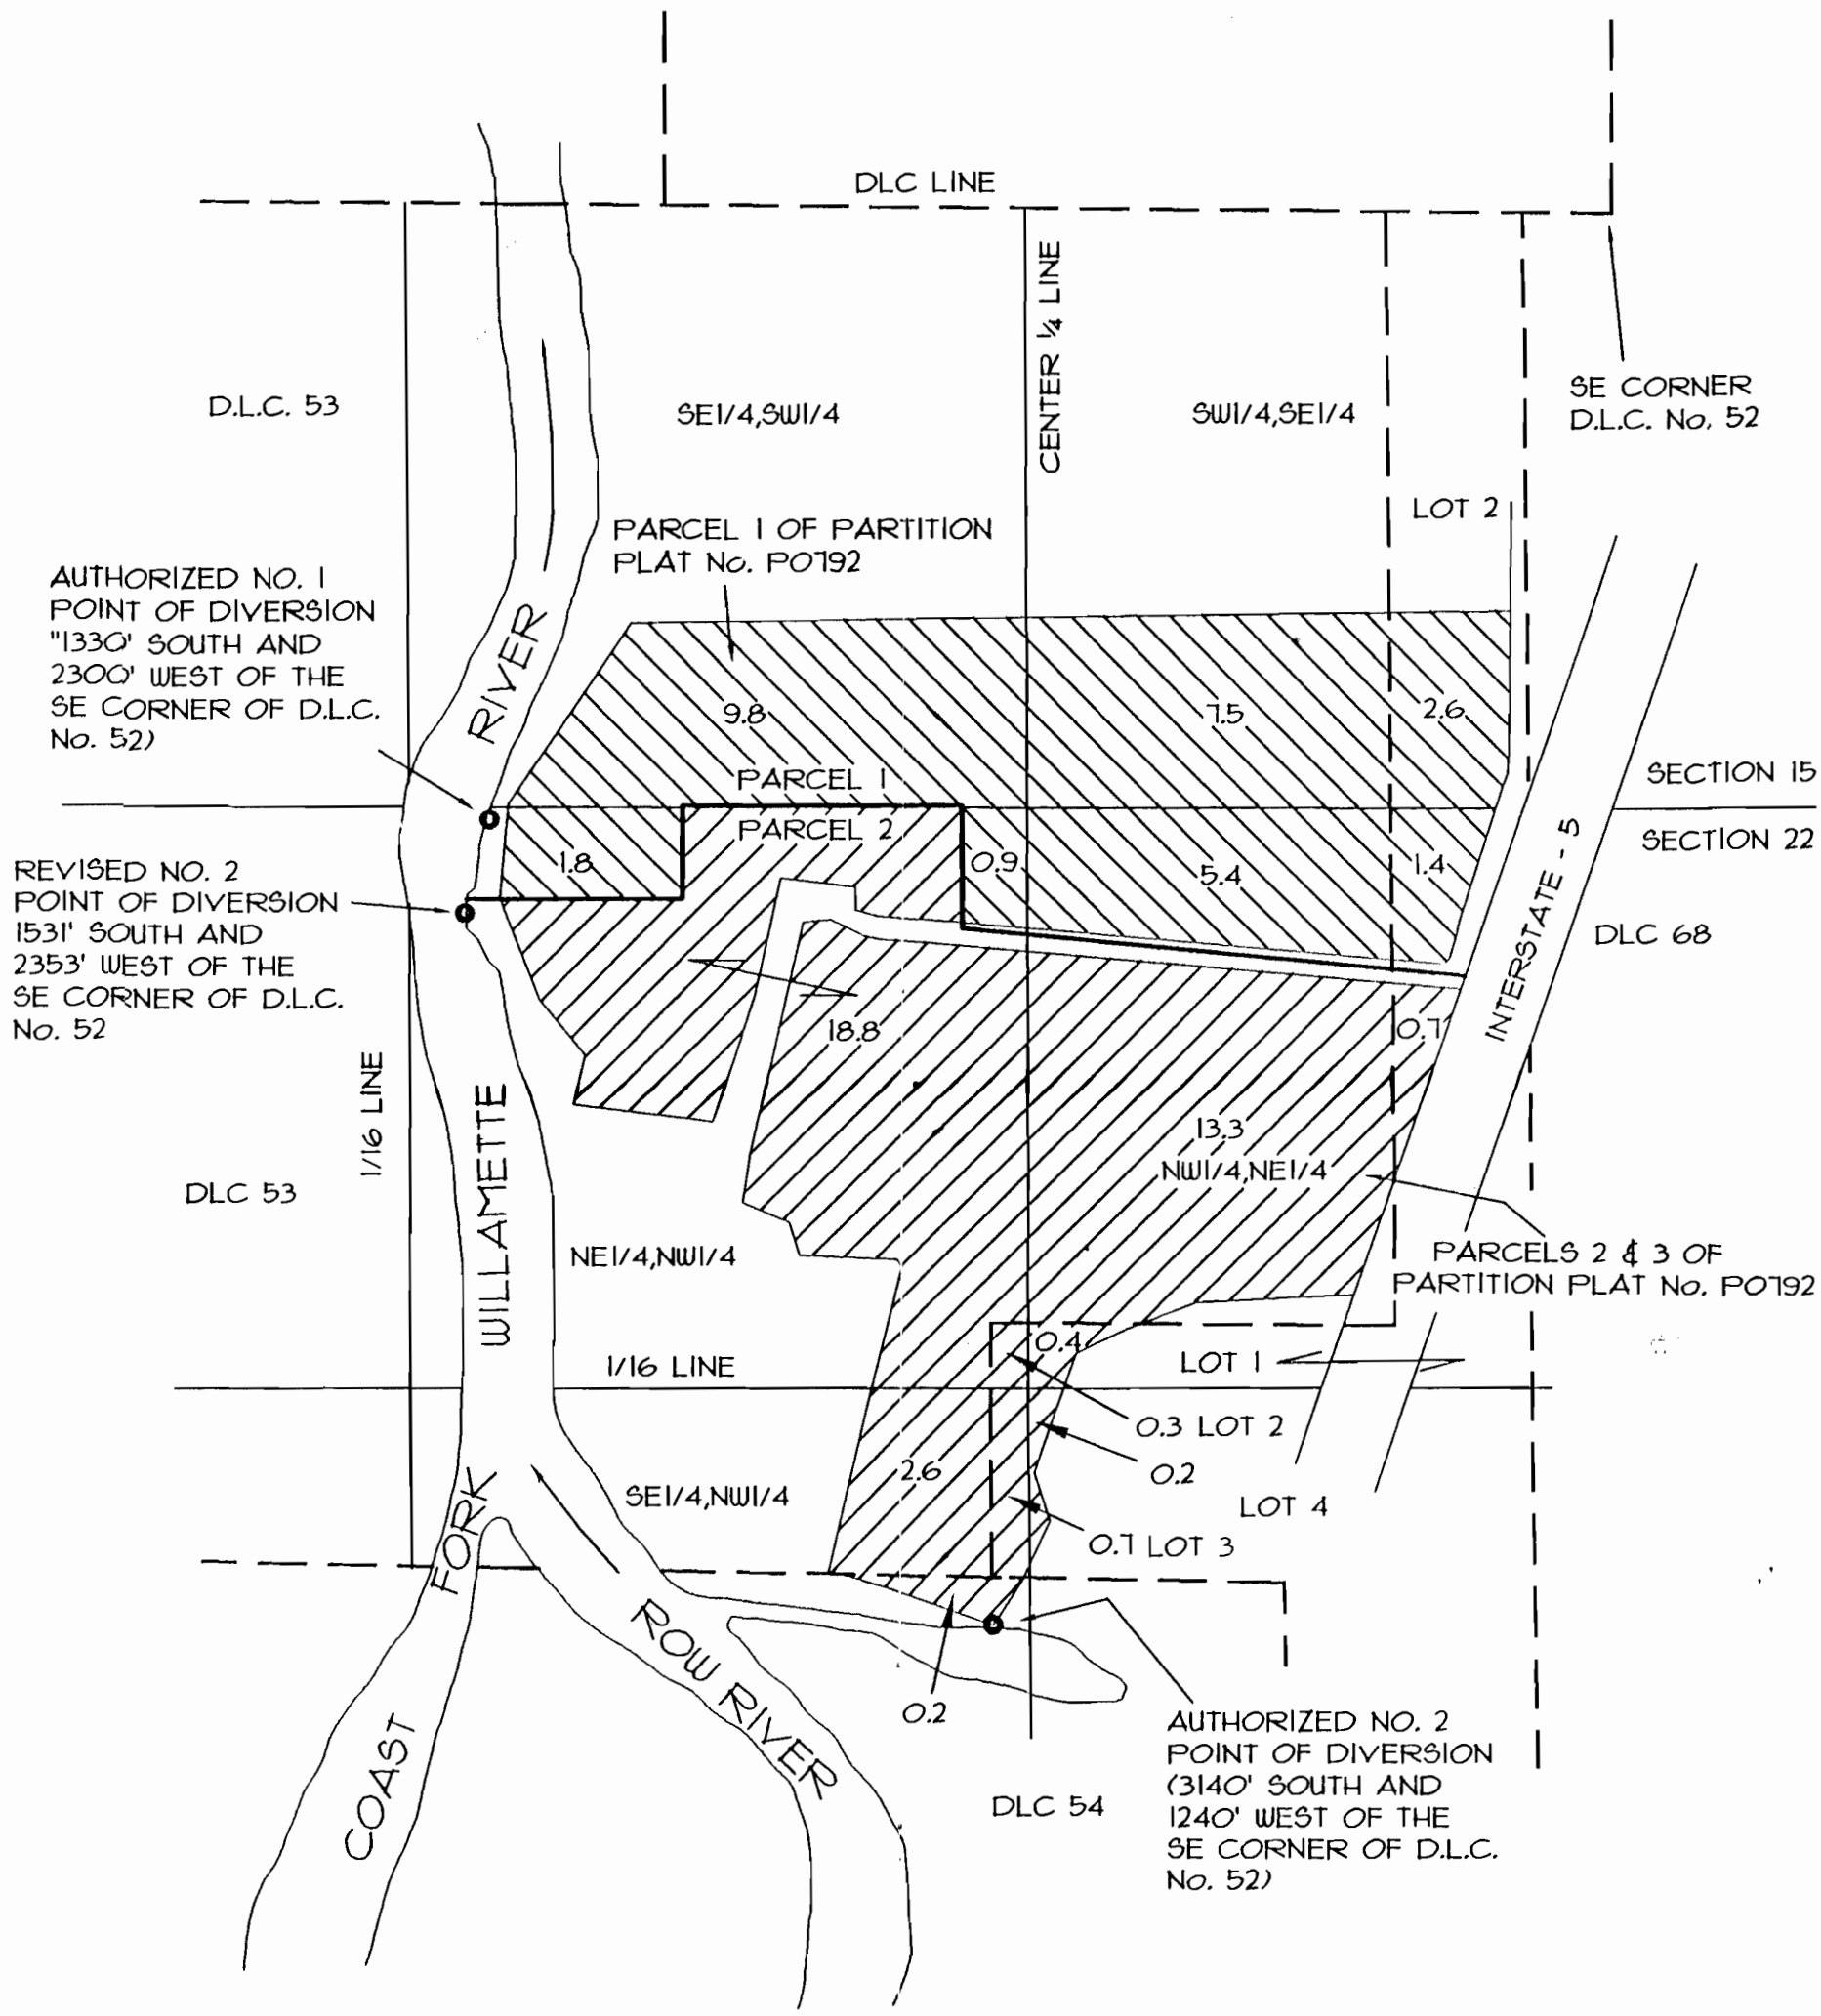

SCALE: 1" = 400'

THIS MAP IS FOR THE PURPOSE OF IDENTIFIYING THE WATER RIGHT ONLY AND IS NOT INTENDED TO PROVIDE LEGAL DIMENSIONS OR LOCATIONS OF PROPERTY OWNERSHIP LINES.

Certified Water Right Examiner
#064
Russell D. Hendricks
Russell D. Hendricks
November 19,1987
STATE OF OREGON
RENEWAL 6/30/01

96197TWR.DWG: 08/25/99