


# TOWNSHIP 18 SOUTH, RANGES 11 & 12 EAST, W.M.

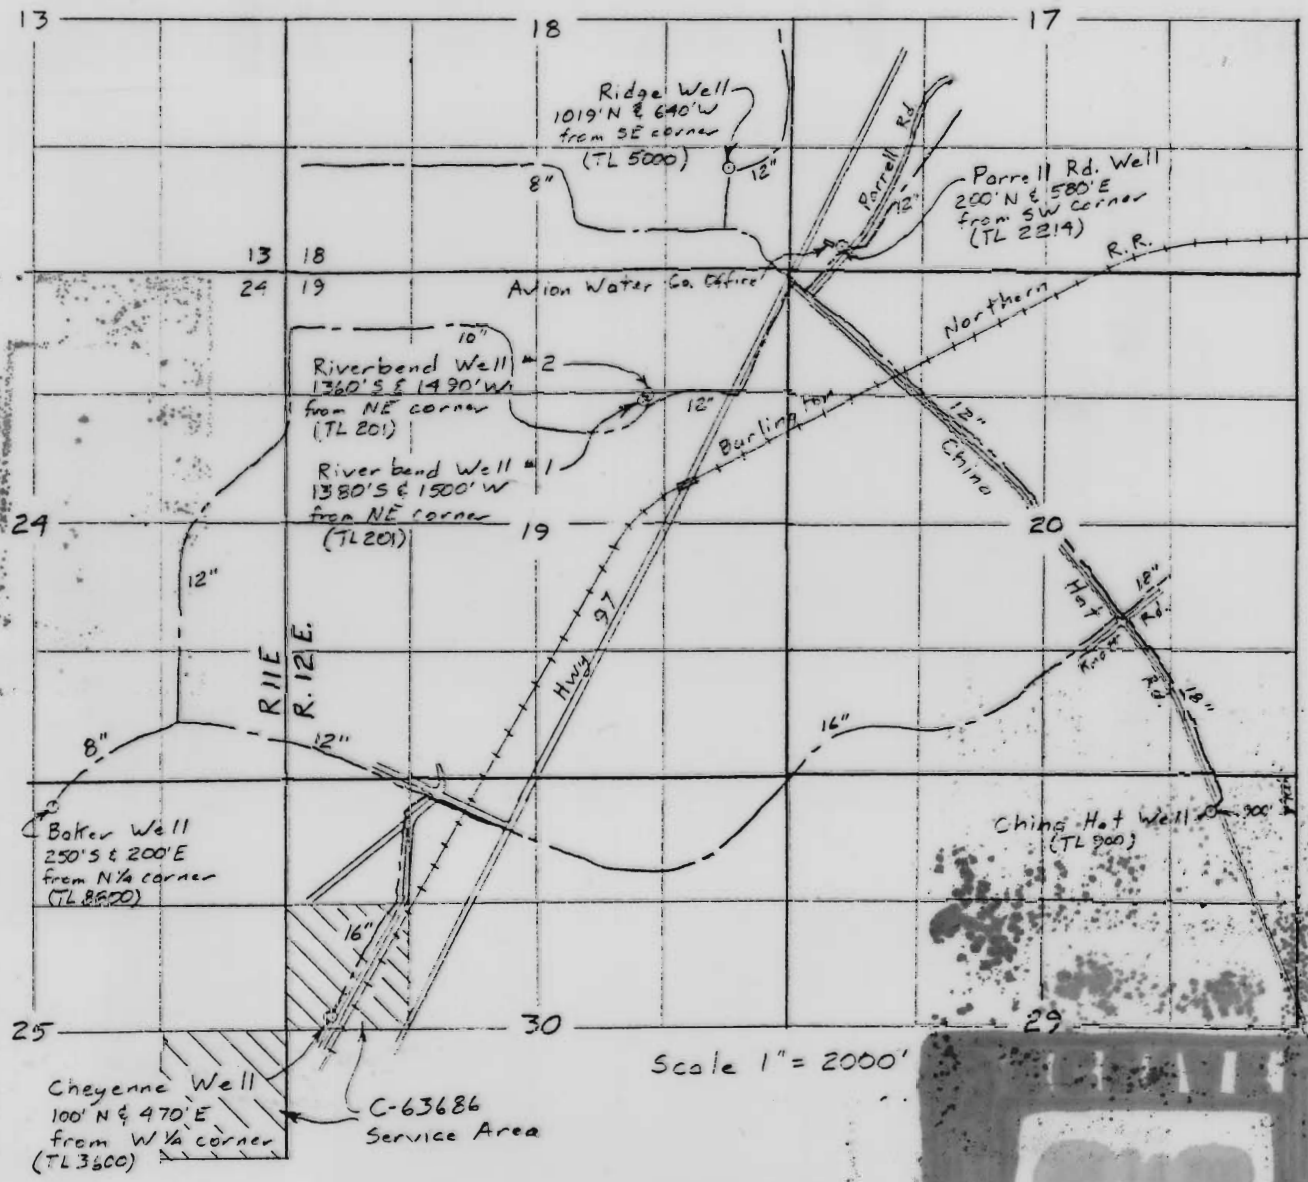


Scale 1" = 2000'

Surveyed Jan 5, 6 & 11, 2000

Claim of Beneficial Use Map  
for  
AVION WATER CO., INC.

T-7779

This map is for the purpose of  
locating a water right only  
and has no intent to provide  
legal dimensions or the location  
of property lines.


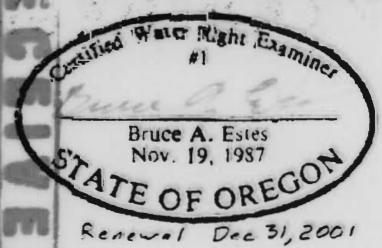


Sheet 1 of 4


**ESTES SURVEYS**  
 PO Box 17519      60382 Arnold Rd  
 Salem, OR 97305-7519      Bend, OR 97702  
 (503) 585-7593      (541) 382-7391

T. 17 S., R. 13 E., W. M.


T. 17 S., R. 12 E., W. M.

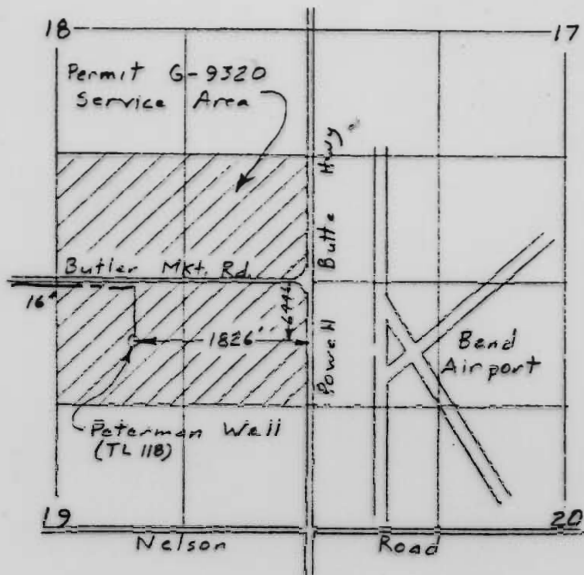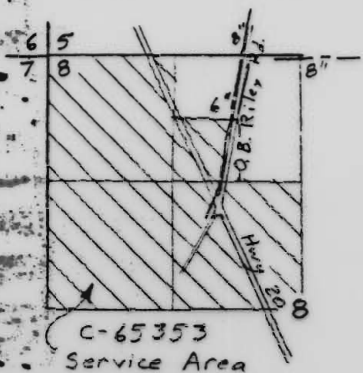

T. 18 S., R. 12 E., W. M.

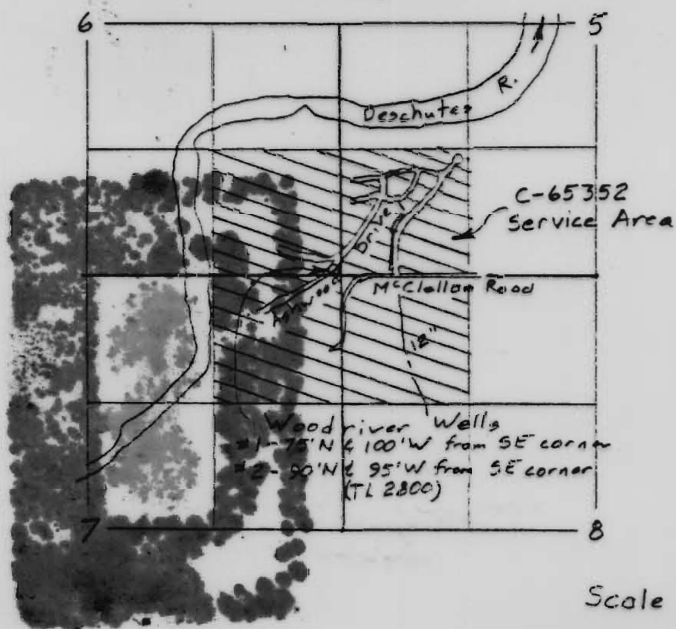

T. 18 S., R. 12 E., W. M.


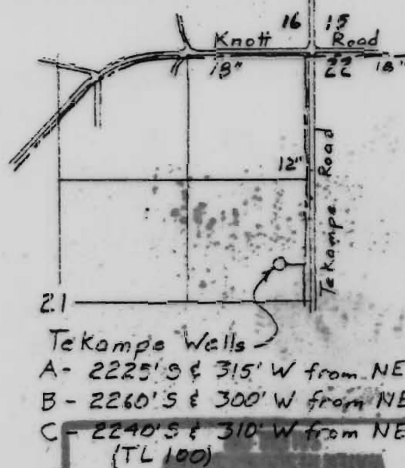


Scale 1" = 2000'

Surveyed Jan 5, 6 & 11, 2000

Claim of Beneficial Use Map  
for  
AVION WATER CO., INC.

T- 7779

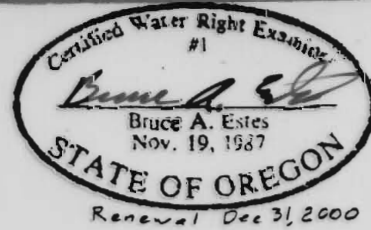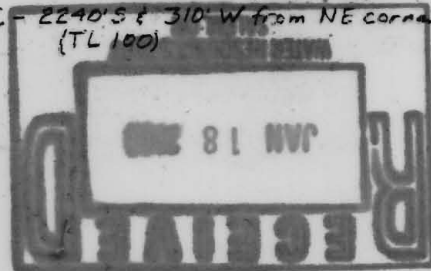



Sheet 2 of 4

This map is for the purpose of locating a water right only and has no intent to provide legal dimensions or the location of property lines.

**ESTES SURVEYS**


PO Box 17519	60382 Arnold Rd
Salem, OR 97305-7519	Biend, OR 97702
(503) 585-7593	(541) 382-7391

T. 16 S., R. 12 E., W. M.

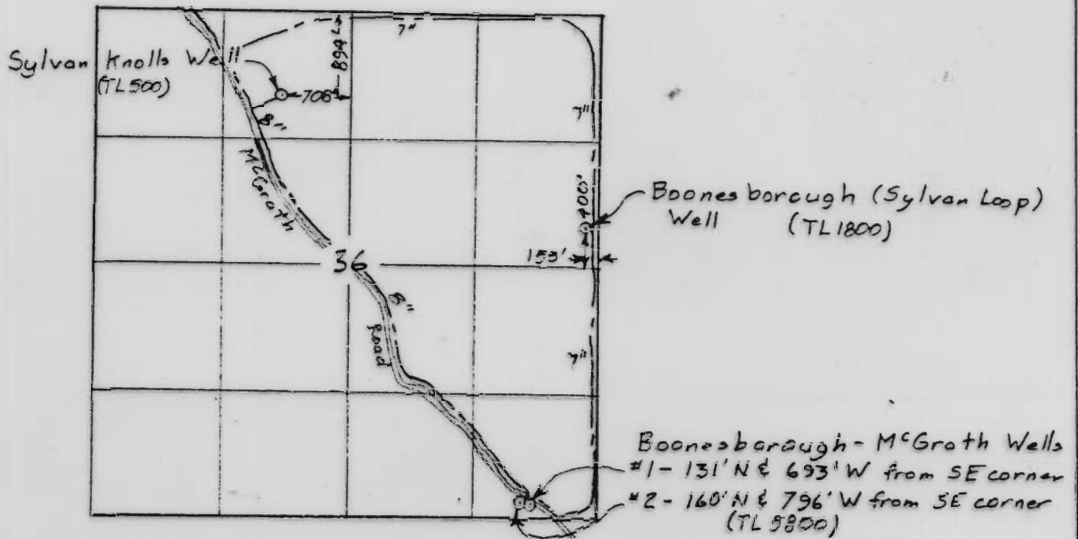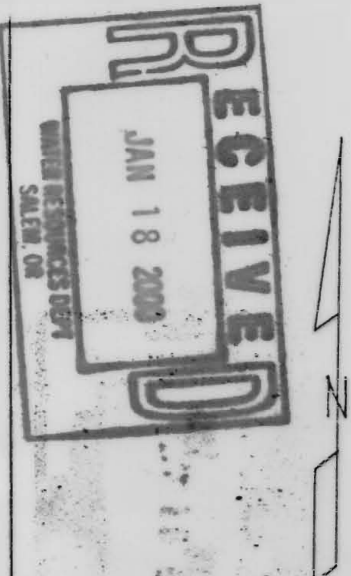

Scale 1" = 2000'

T. 18 S., R. 13 E., W. M.

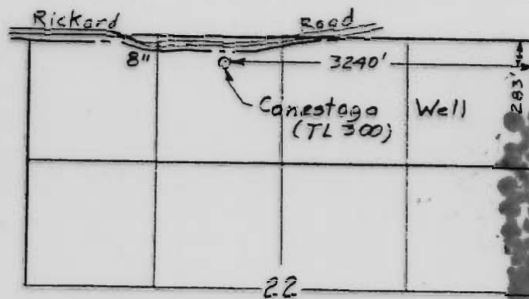


Surveyed Jan 5, 6 & 11, 2000

Claim of Beneficial Use Map for

AVION WATER CO., INC.

T-7779

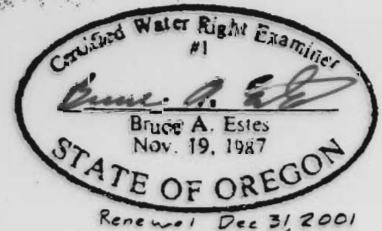

Sheet 3 of 4

This map is for the purpose of locating a water right only and has no intent to provide legal dimensions or the location of property lines.



ESTES SURVEYS

PO Box 17519 60382 Arnold Rd Salem, OR 97305-7519 Bend, OR 97702 (503) 585-7593 (541) 382-7391

TOWNSHIP 18 SOUTH,  
RANGE 13 EAST, W.M.




Scale 1" = 2000'

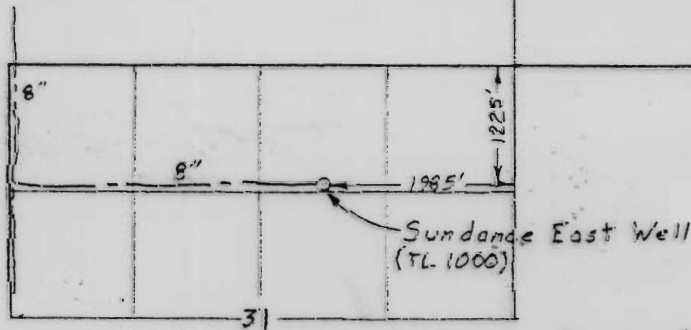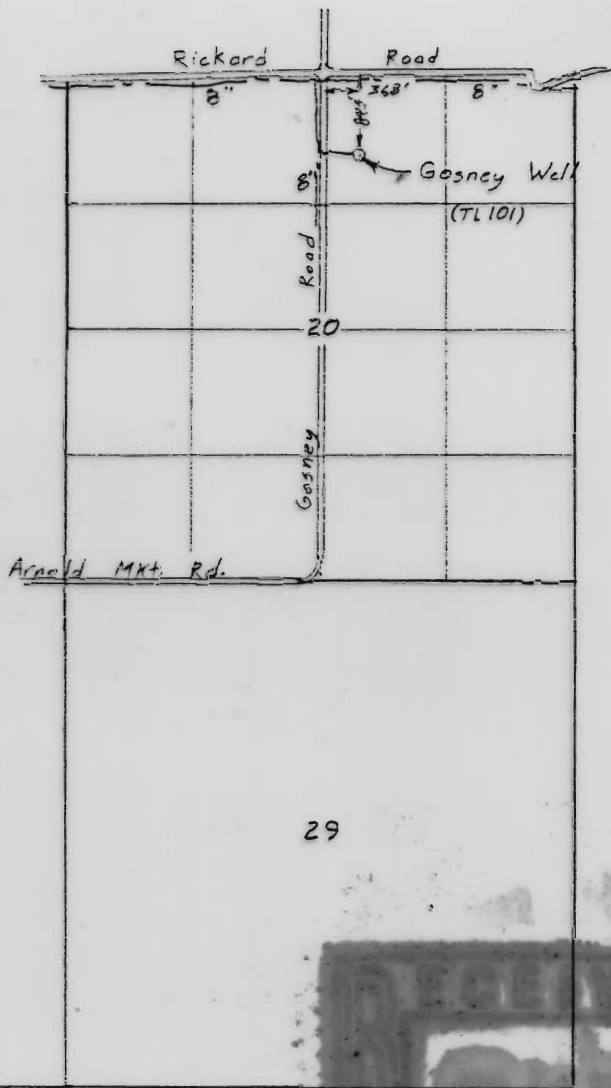

Surveyed Jan 5, 6 & 11, 2000

Claim of Beneficial Use Map  
for  
AVION WATER CO., INC.

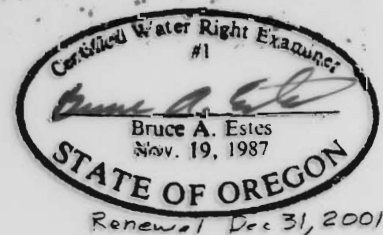

Renewal Dec 31, 2001

Sheet 4 of 4

T- 7779

This map is for the purpose of locating a water right only and has no intent to provide legal dimensions or the location of property lines.

**ESTES SURVEYS**

PO Box 17519      60382 Arnold Rd  
(503) 585-7593      (541) 382-7391