




1" = 400'

NOTE: THIS MAP WAS PREPARED FOR THE PURPOSE OF IDENTIFYING THE LOCATION OF WATER RIGHTS ONLY, AND IS NOT INTENDED TO PROVIDE DIMENSIONS OR THE LOCATION OF PROPERTY OWNERSHIP LINES.


EXISTING FAIRWAY (TYPICAL)
EXISTING LAKE (TYPICAL)

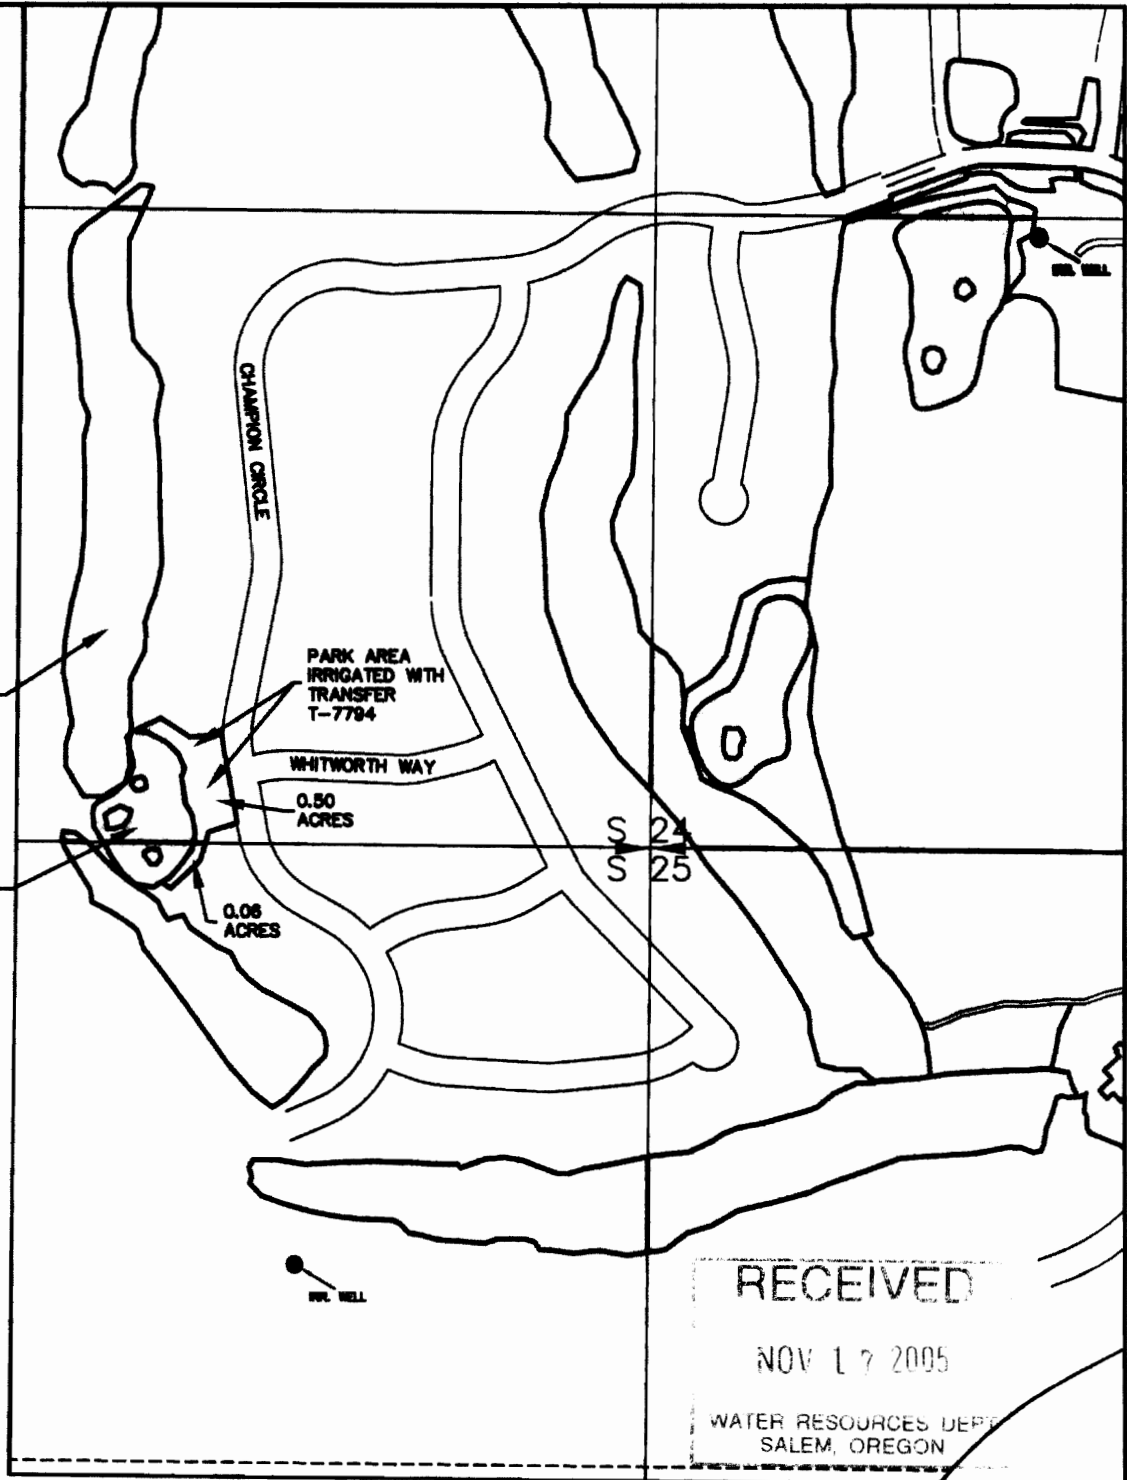

RECEIVED

NOV 17 2005

WATER RESOURCES DEPT
SALEM, OREGON

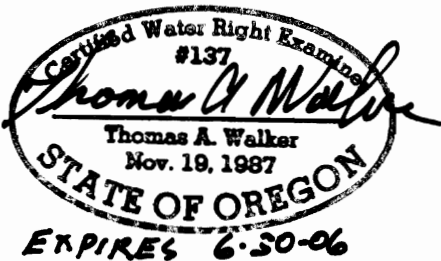

LOCATED IN SESW SECTION 24
AND THE NENW SECTION 25,
T17S, R11E, WM
TAX LOT 17-11-24 CD 500

PLACE OF USE
FINAL PROOF
SURVEY
FOR TRANSFER T-7794
UNDER

Application No. G-12156 Permit No. G-11108

Certificate No. 80653

IN NAME OF

Brooks Resources Corporation

Surveyed Sept., 19 95, by Thomas A. Walker, P.E., C.E.R.E.

LEGEND:



Totals: (in acres)
Irrigated 0.56

