

Existing Diversion Point


New Diversion Point

T 7803

Watts School Pump Station

RECEIVED
JUL - 1 1997
WATER RESOURCES DEPT.
SALEM, OREGON

INGTON

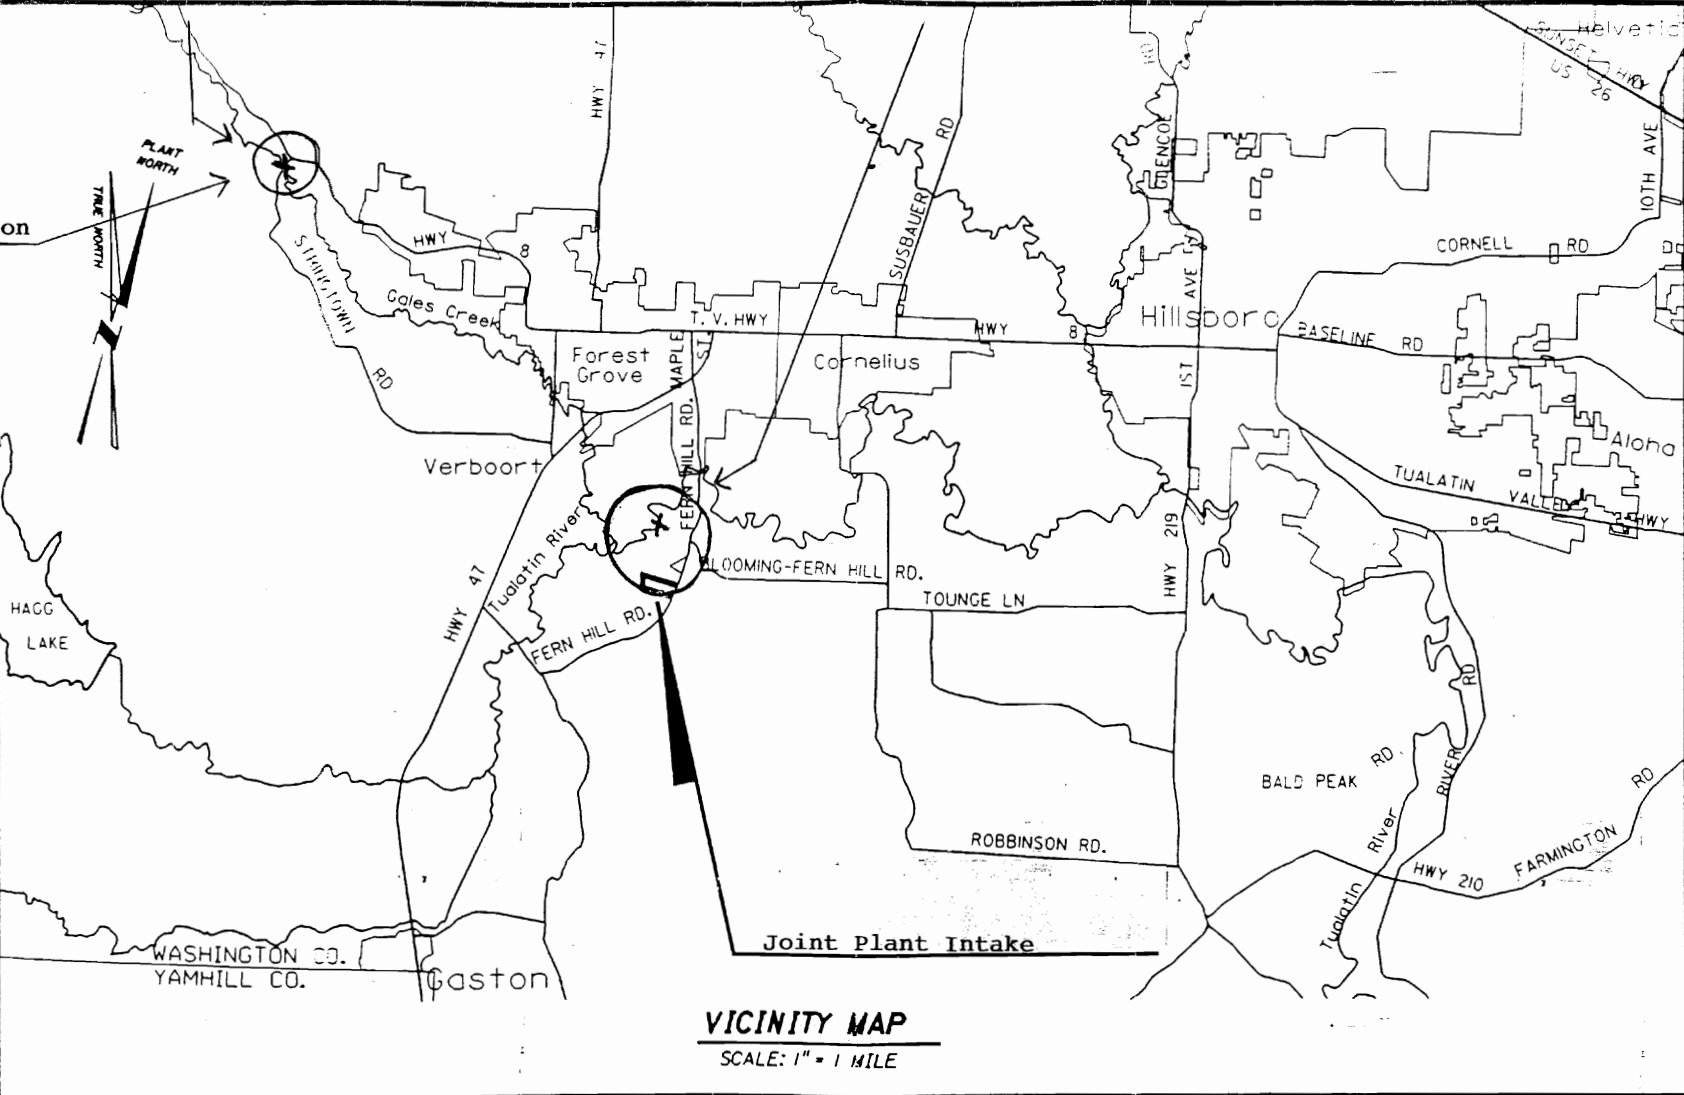

VICINITY MAP
SCALE: 1" = 1 MILE



RAW WATER