


FINAL PROOF SURVEY MAP

T 5 S, R 2 W, W.M.
Section 25

Prepared for Larry Schiedler

Transfer T-8341

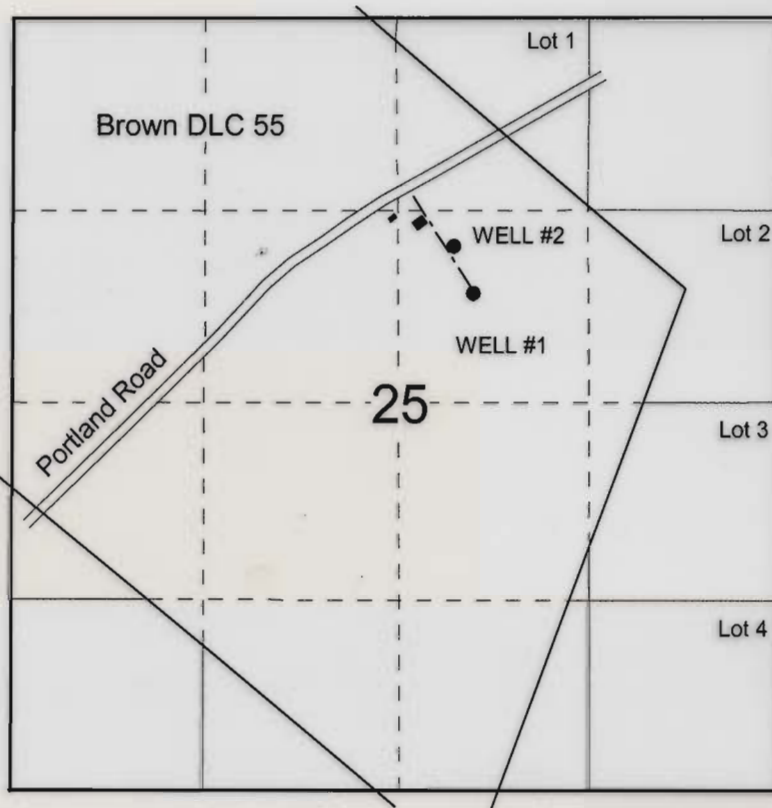


WELL # 1: 10' S & 1450' W of the NE Corner DLC 55

WELL # 2: 320' N & 1620' W of the NE Corner DLC 55

This map is for water
right purposes only.

1" = 1320'

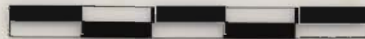

0

2500

