


TOWNSHIP 2 SOUTH, RANGE 1 WEST, W.M.
Section 21

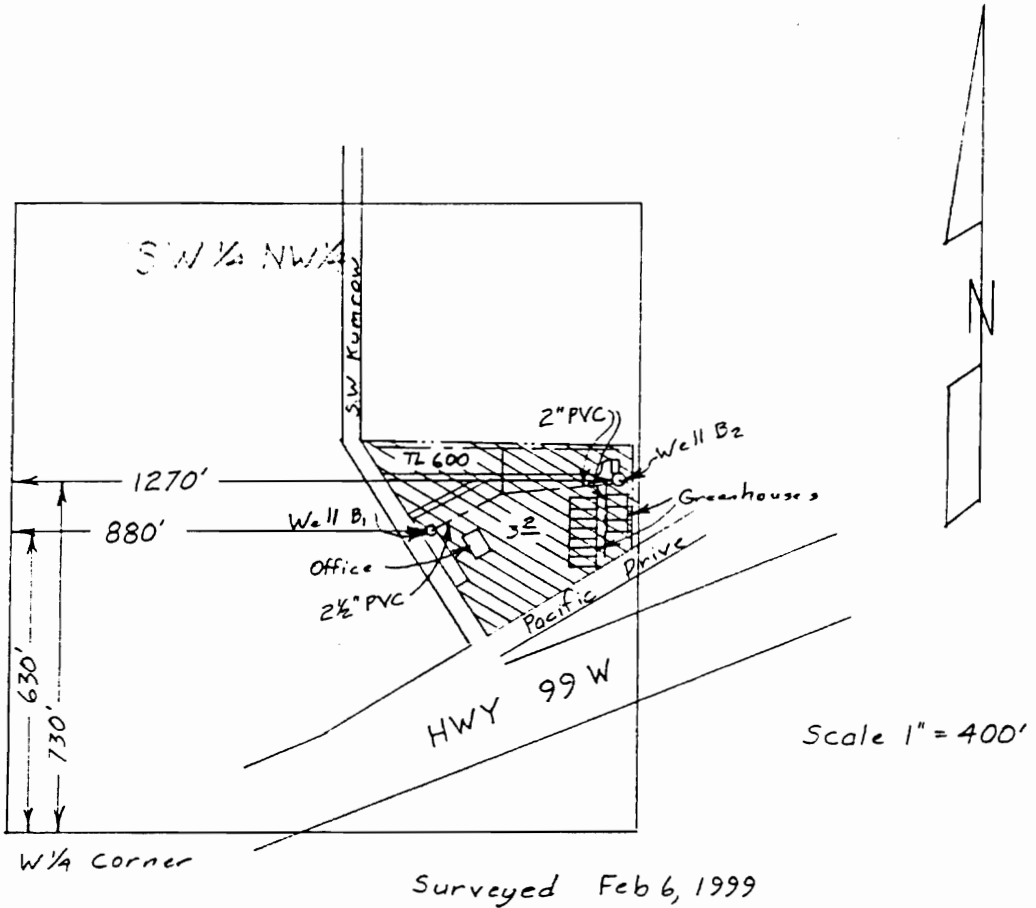


Claim of Beneficial Use Map
for
LOEN NURSERY CO.

RECEIVED

OCT 11 1999

RESOURCES DEPT.
SALEM, OREGON

App G-12495
Per G-12073
& T-7827

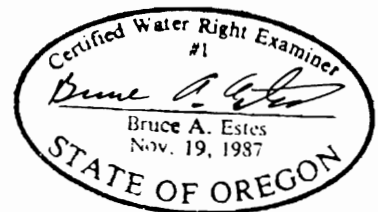

Renewal: Dec 31, 1999

This map is for the purpose of
locating a water right only
and has no intent to provide
legal dimensions or the location
of property lines.

ESTES SURVEYS

6293 Sunnyview Rd. NE 60382 Arnold Rd.
Salem, OR 97305 Bend, OR 97702
(503) 585-7593 (503) 382-7391