

T 7785

RECEIVED


JUN 05 1997

WATER RESOURCES DEPT  
SALEM, OREGON

T.7S. & 8S., R.4W., W.M.

Scale: 1" = 1320'

NOTE: MAP IS FOR  
PURPOSE OF IDENTIFYING  
LOCATION OF WATER RIGHT AND  
HAS NO INTENT TO DIMENSION  
OR LOCATE PROPERTY OWNERSHIP  
LINES.

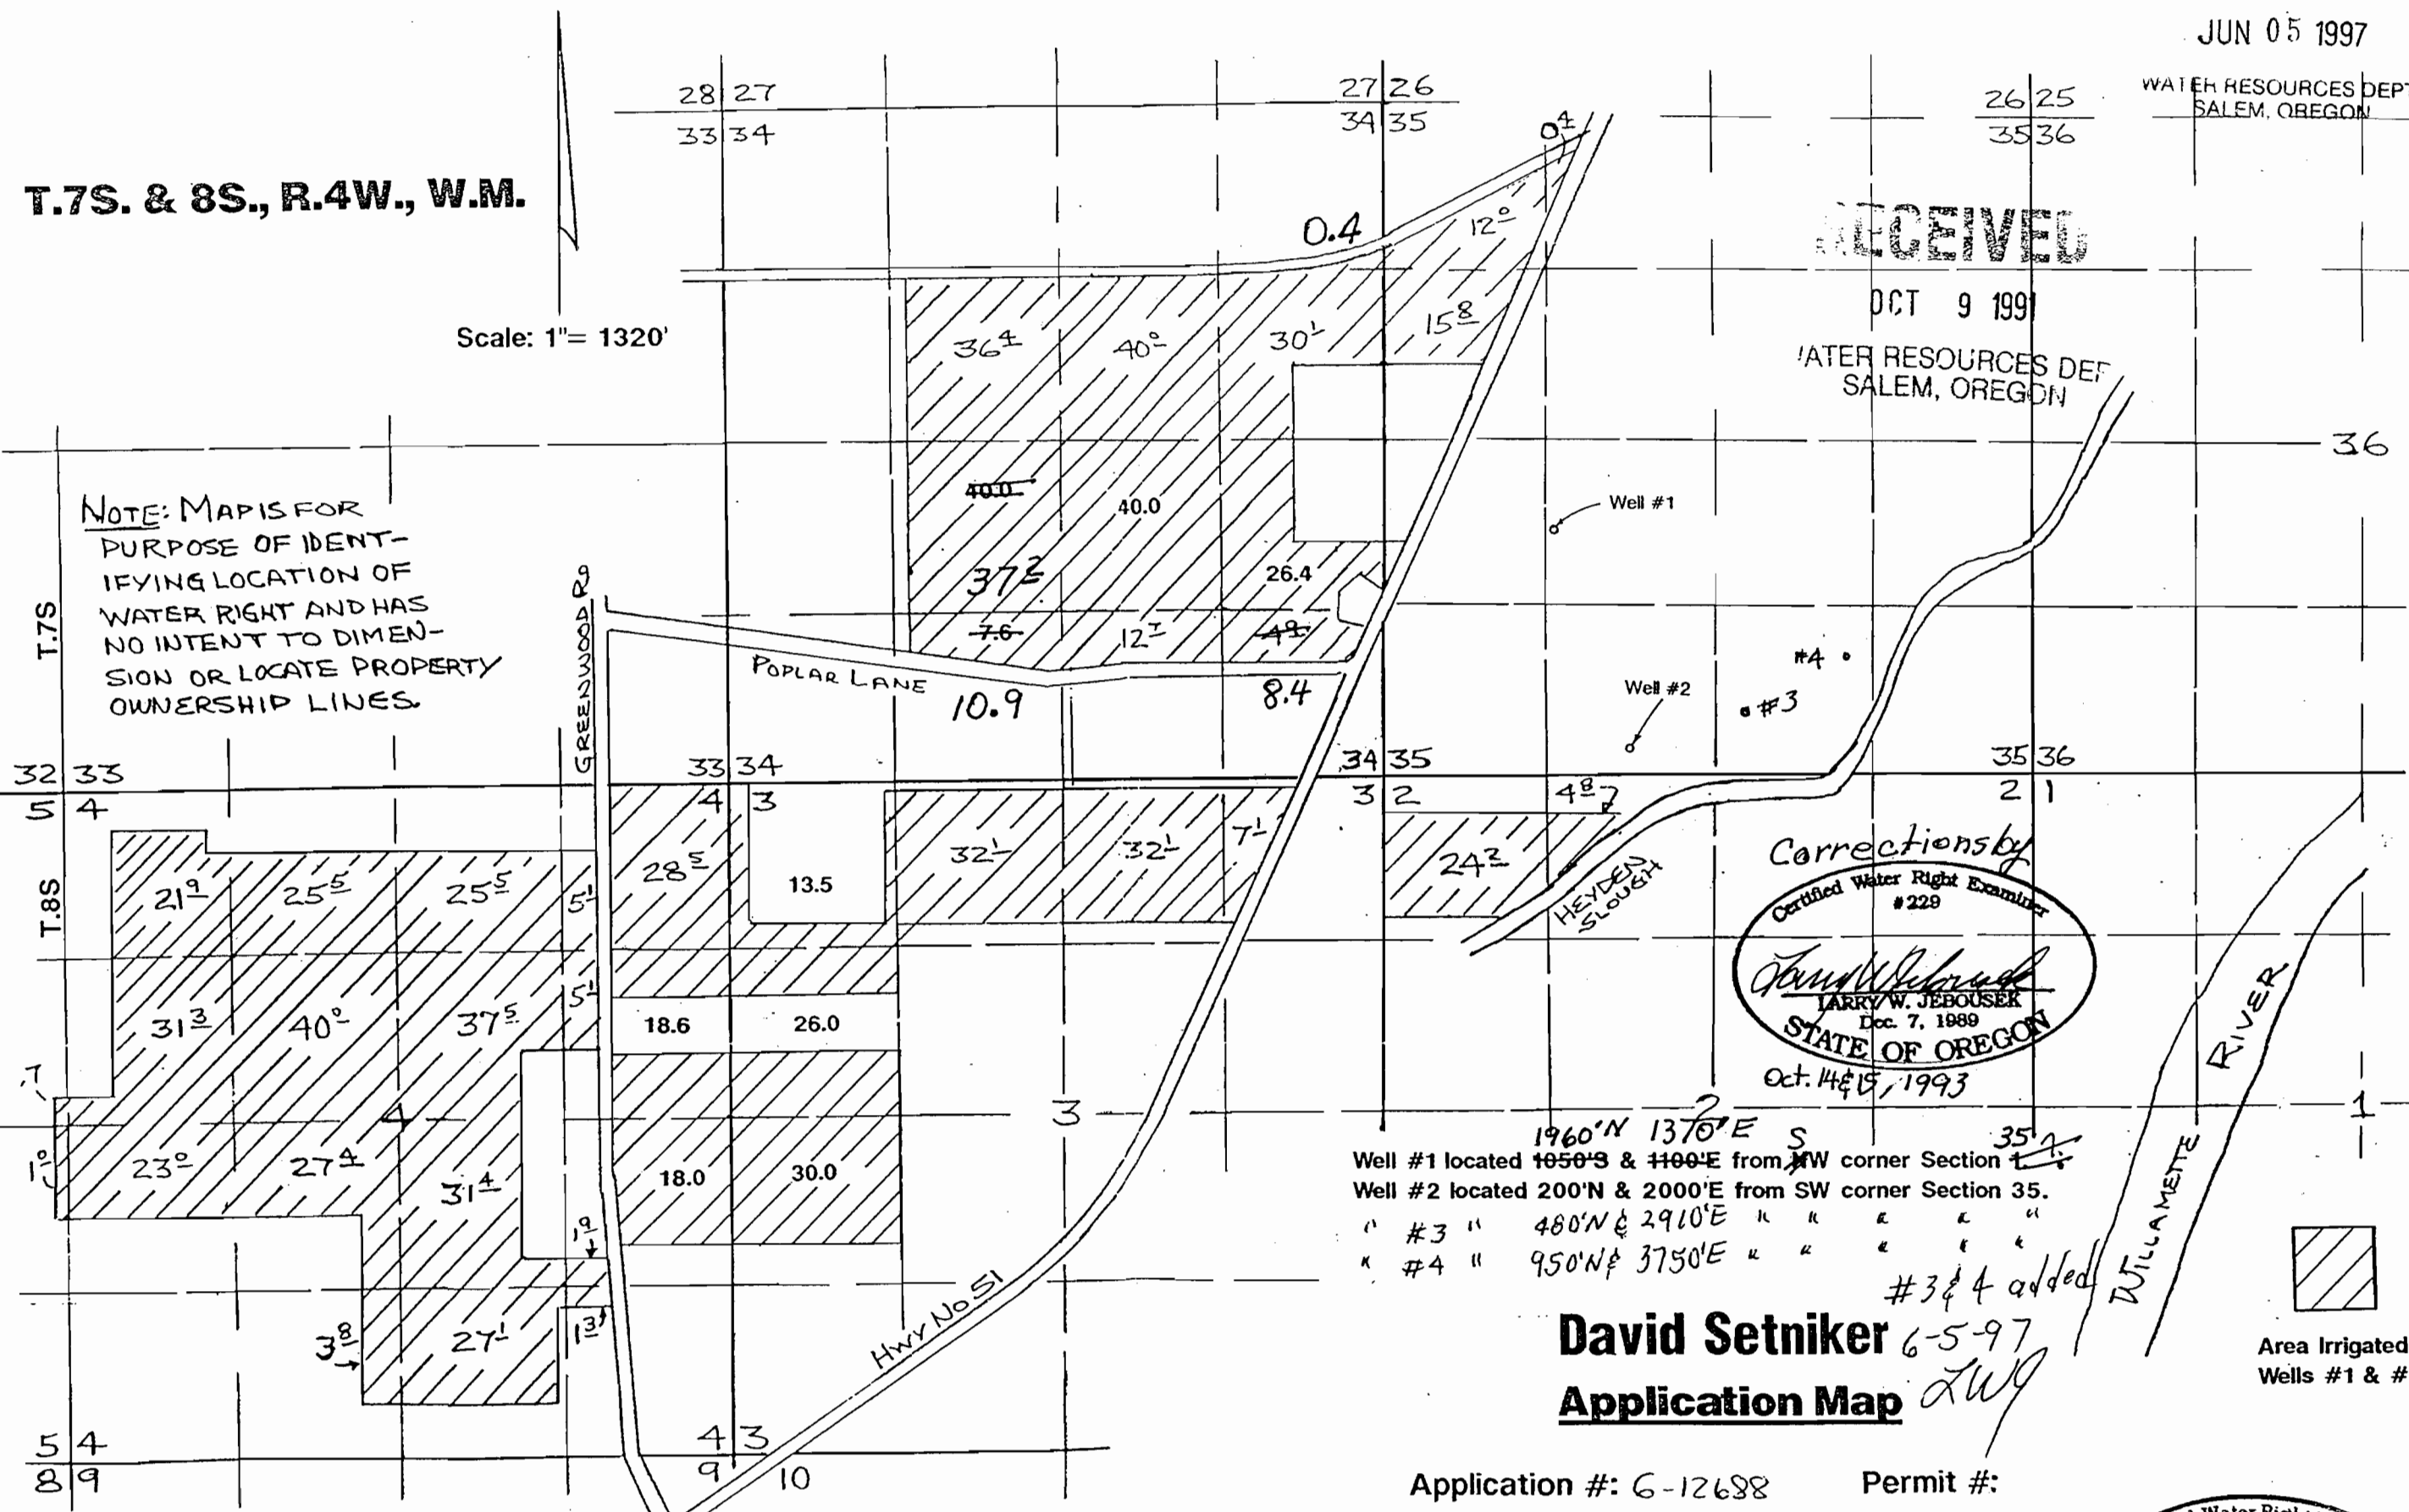

RECEIVED


WATER RESOURCES DEPT  
SALEM, OREGON

Corrections by  
 Certified Water Right Examiner  
 #229  
*Larry W. Jebousek*  
 LARRY W. JEBOUSEK  
 Dec. 7, 1989  
 STATE OF OREGON  
 Oct. 14 & 15, 1993

Well #1 located 1960'N & 1370'E S 35' from NW corner Section 35.  
 Well #2 located 200'N & 2000'E from SW corner Section 35.  
 " #3 " 480'N & 2910'E " " " " "  
 " #4 " 950'N & 3750'E " " " " "

#3 & 4 added

David Setniker 6-5-97  
Application Map *DSW*

Application #: G-12688

Permit #:

Certified Water Right Examiner  
 #058  
*James Grimm*  
 James Grimm  
 Nov 19 1987

Area Irrigated  
Wells #1 & #2