

SECTION 1, TOWNSHIP 1 N. RANGE 9 E. W.M.
HOOD RIVER COUNTY, OREGON

RECEIVED

OCT 01 1999

WATER RESOURCES DEPT.
SALEM OREGON

NEW WELL
(DIVERSION PT. No. 2)
1365' S. AND 123' W.
OF N.1/4 CORNER
SECTION 1

PIPE
CREEK

EXISTING WELL
(DIVERSION PT. No. 1)
1400' S. AND 40' W.
OF N.1/4 CORNER
SECTION 1

FISH PONDS

SE.1/4 OF NW.1/4



SW.1/4 OF NE.1/4

S 09°48'54" W
1244.09'

COUNTY ROAD

NW.1/4 OF NE.1/4

N.1/4 COR.
SEC. 1.
FD. 2 ORG. B.T. STUMPS

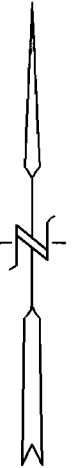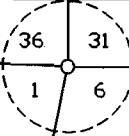

WATER RIGHT
FINAL PROOF SURVEY

SCALE: 1" = 400'

CERTIFICATE No. 55582

PERMIT No. G-8110 T-7847

IN THE NAME OF:

EDWARD MCLEARY

DATE: SEPTEMBER 22, 1999

BY: TENNESON ENGINEERING CORP.
409 LINCOLN STREET,
THE DALLES, OREGON. 97058
PH. 541-296-9177
FAX 541-296-6657

NOTE:

"THIS MAP IDENTIFIES THE LOCATION OF
THE WATER RIGHT ONLY AND IS NOT
INTENDED TO PROVIDE DIMENSIONS OR
LOCATE PROPERTY OWNERSHIP LINES."

