


WATER RIGHT TRANSFER APPLICATION MAP CHANGE IN POINT OF DIVERSION

1/4 31 (T.36 S.)

T.37 S. R.06 W..
SECTION 6 W.M.

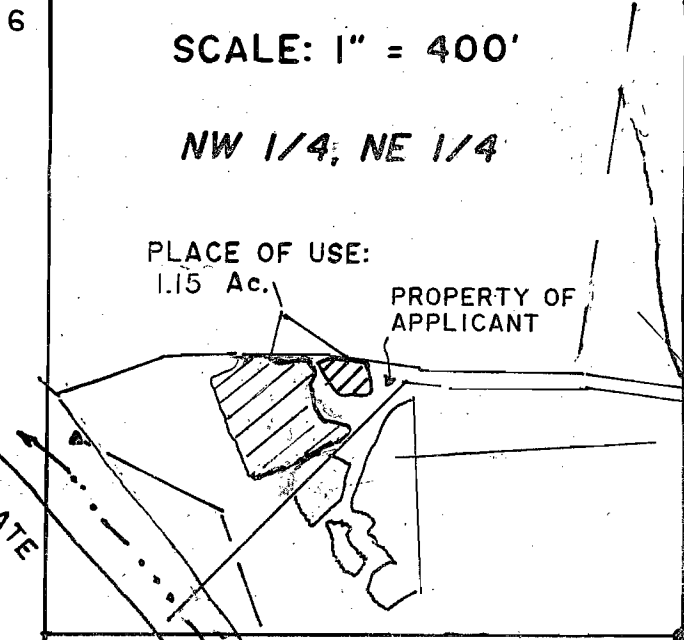


Asses. Map
37-06-06-00
T.L. 500

PROPOSED POINT OF DIVERSION:
N 71°45' W, 1325 FEET FROM
THE NE 1/16TH COR. SECTION 6


NE 1/16TH COR.
FD: IRON ROD PER
SURVEY 282-78

APPLICANT:
PAUL J. JAROMSCAK
3980 HELMS ROAD
GRANTS PASS, OR 97527

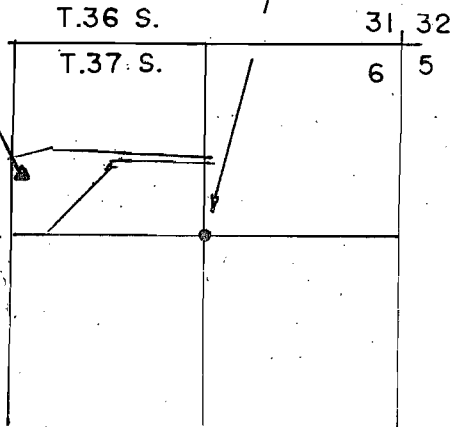


AUTHORIZED POINT OF DIVERSION:
JESS DITCH 780' NORTH and
800' EAST FROM SW COR. SECTION 5

APPLEGATE RIVER

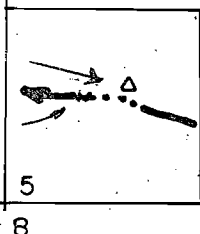

PREPARED BY:
JONATHAN C. SPERO C.W.R.E. 123
1002 KINCAID RD./P.O. BOX 16
WILLIAMS, OREGON 97544
PH. (541) 846-6845.

SCALE: 1" = 1320

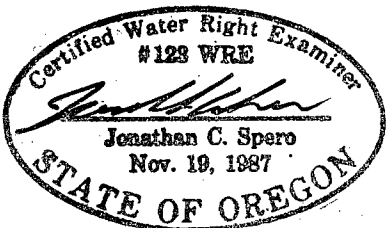

LICENSE RENEWAL DATE:
JUNE 30, 2002

Map modified Nov. 5, 2007
MAP MODIFIED 08/30/02

MAP PREPARED: MAY 23, 2002

THIS MAP IS FOR THE PURPOSE OF
IDENTIFYING THE LOCATION OF THE
WATER RIGHT ONLY, AND IS NOT IN-
TENDED TO PROVIDE LEGAL DIMEN-
SIONS OR LOCATIONS OF PROPERTY
OWNERSHIP LINES.

CLAIM OF BENEFICIAL USE MAP

PAUL J. JAROMSCAK

TRANSFER No. 9144


TOWNSHIP 37 SOUTH, RANGE 6 WEST, SECTION 6, W.M.

MAP 37-06-06-00 T.L. 500

ADDRESS: 3980 HELMS RD.

GRANTS PASS, OREGON 97527

THIS MAP IS FOR THE PURPOSE
OF IDENTIFYING THE LOCATION
OF THE WATER RIGHT ONLY,
AND IS NOT INTENDED TO PROVIDE
LEGAL DIMENSIONS OR LOCATIONS
OF PROPERTY OWNERSHIP LINES.

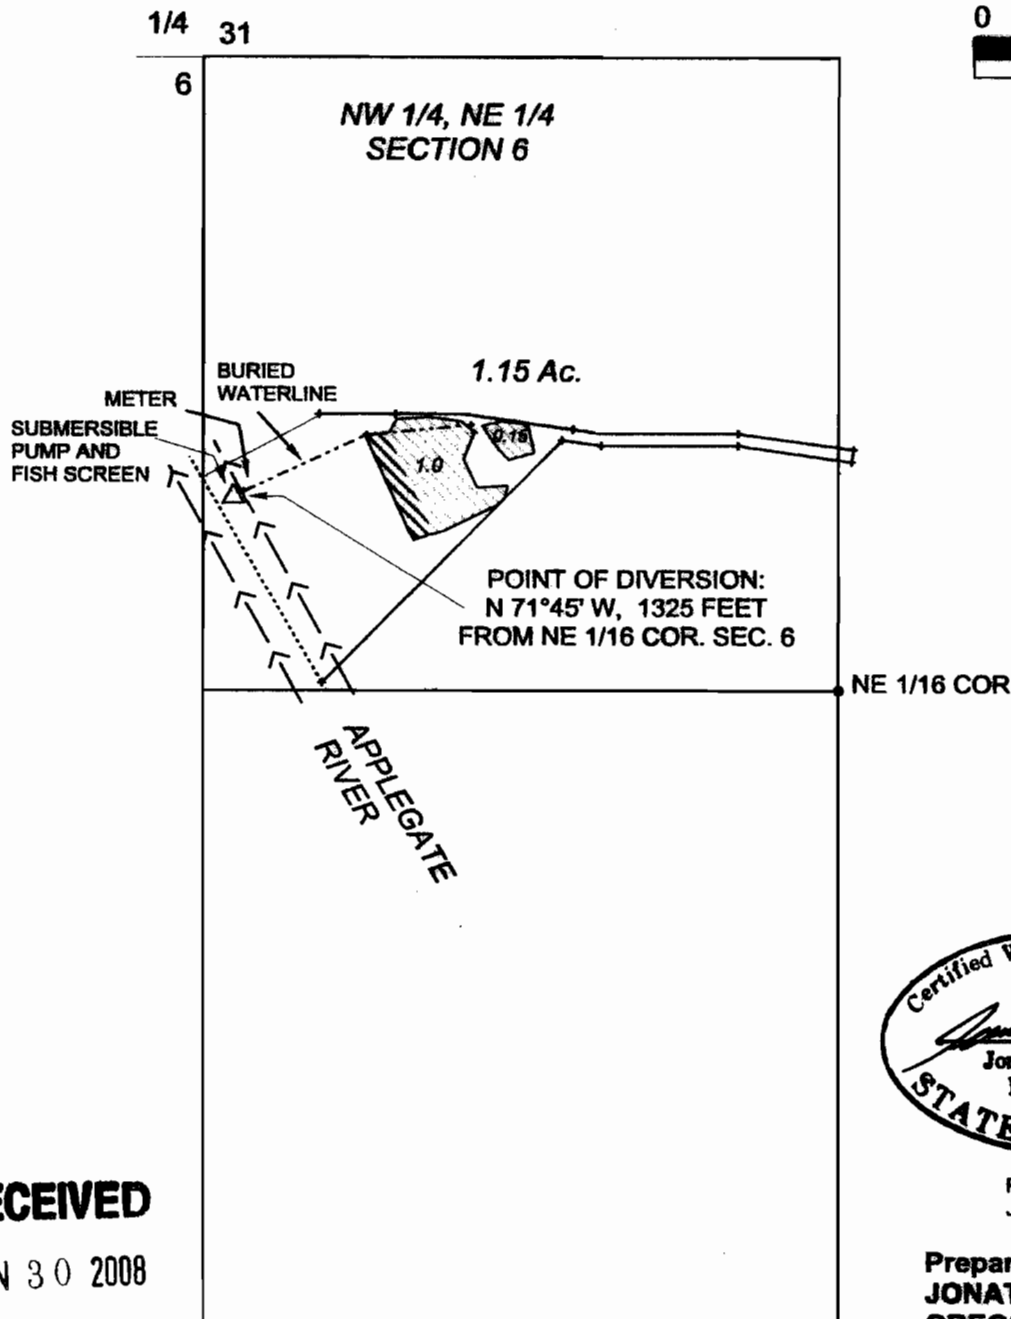

RECEIVED

JUN 30 2008

WATER RESOURCES DEPT
SALEM, OREGON

FORMER POINT OF DIVERSION:
JESS DITCH 780' N & 800' E
FROM SW CORNER, SECTION 5
(T.37 S. R.6 W. W.M.)



RENEWAL DATE:
JUNE 30, 2010

Prepared By:
JONATHAN C. SPERO
OREGON R.L.S. #2309
P.O. BOX 16
WILLIAMS OR 97544
Ph. (541) 846-6845

INSPECTION JUNE 10, 2008
MAP PREPARED: JUNE 26, 2008