
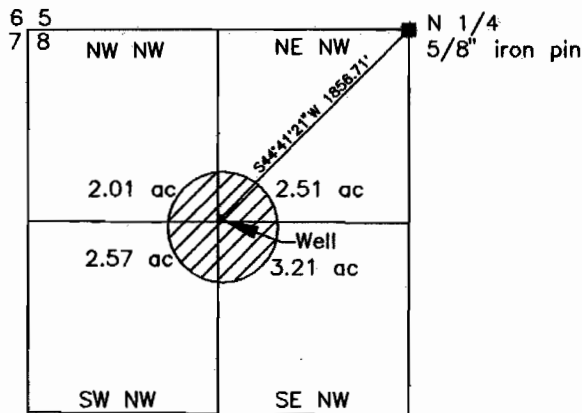



CLAIM OF BENEFICIAL USE MAP
NW 1/4 Section 8, T.27S. R.19E., W.M.
Lake County, Oregon

TAX LOT 700
RICHARD C. SMITH
T-9139

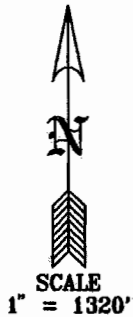

RECEIVED
JUN 27 2006
 WATER RESOURCES DEPT
 SALEM, OREGON

SURVEY BY: SUNDET & ASSOCIATES
 P.O. BOX 1228
 LAKEVIEW, OR 97630
 541-947-3293
 DRAWING NO. 1256WR JUNE 2006

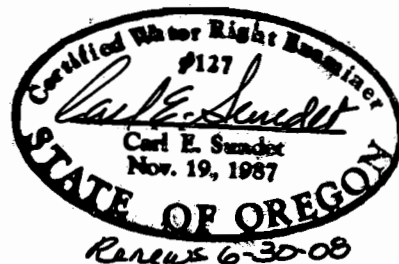

THIS MAP IS FOR THE PURPOSE OF IDENTIFYING THE LOCATION OF THE WATER RIGHT ONLY AND IS NOT INTENDED TO DEFINE THE LOCATION OF PROPERTY OWNERSHIP LINES.