


TOWNSHIP 10 SOUTH, RANGE 17 EAST, W.M.

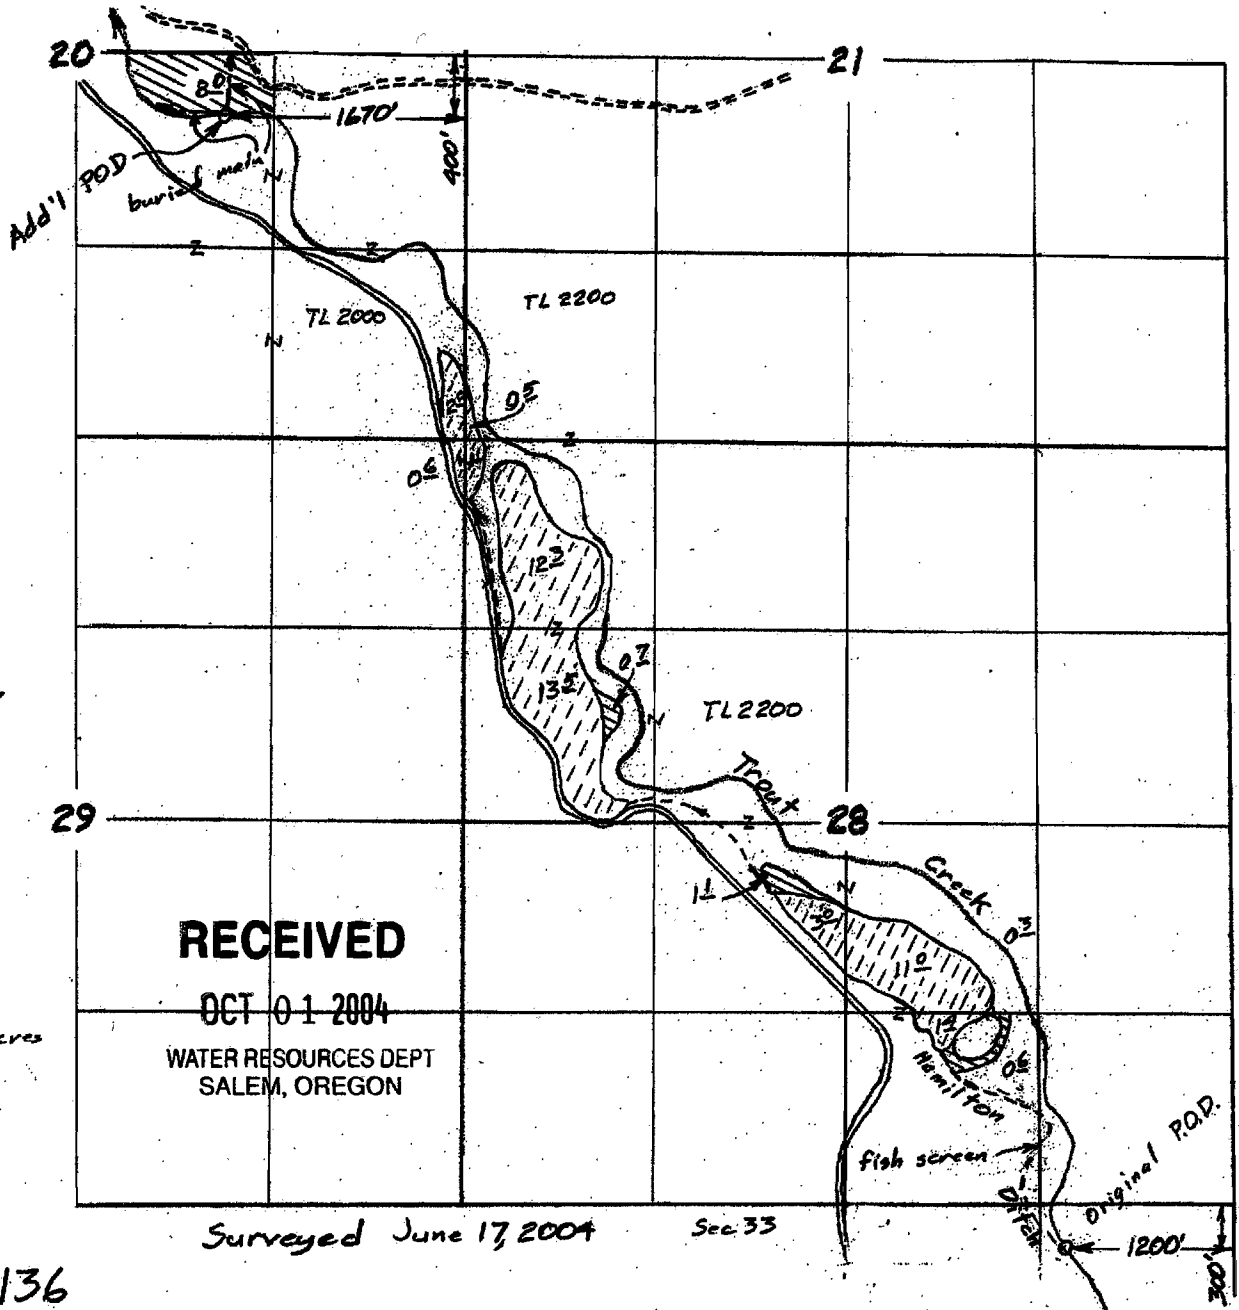

Scale 1" = 1320'
(4" = 1 mile)

RECEIVED

OCT 01 2004

WATER RESOURCES DEPT
SALEM, OREGON


- ⊗ To 103 acres
- ⊕ C-2236

Surveyed June 17, 2004

Sec 33

T-9136

Claim of Beneficial Use Map
for
CORRY WRIGHT

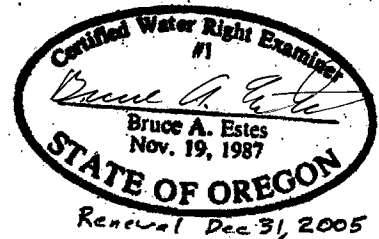

This map is for the purpose of locating a water right only and has no intent to provide legal dimensions or the location of property lines.

ESTES SURVEYS, LLC
 PO Box 17519 60382 Arnold Rd
 Salem, OR 97305-7519 Bend, OR 97702
 (503) 585-7593 (541) 382-7391