


RECEIVED

APR 23 2002

WATER RESOURCES DEPT.
SALEM, OREGON

City of Newberg
Amendment of Permit G-13876, Application G-12515
Five Additional Points of Diversion

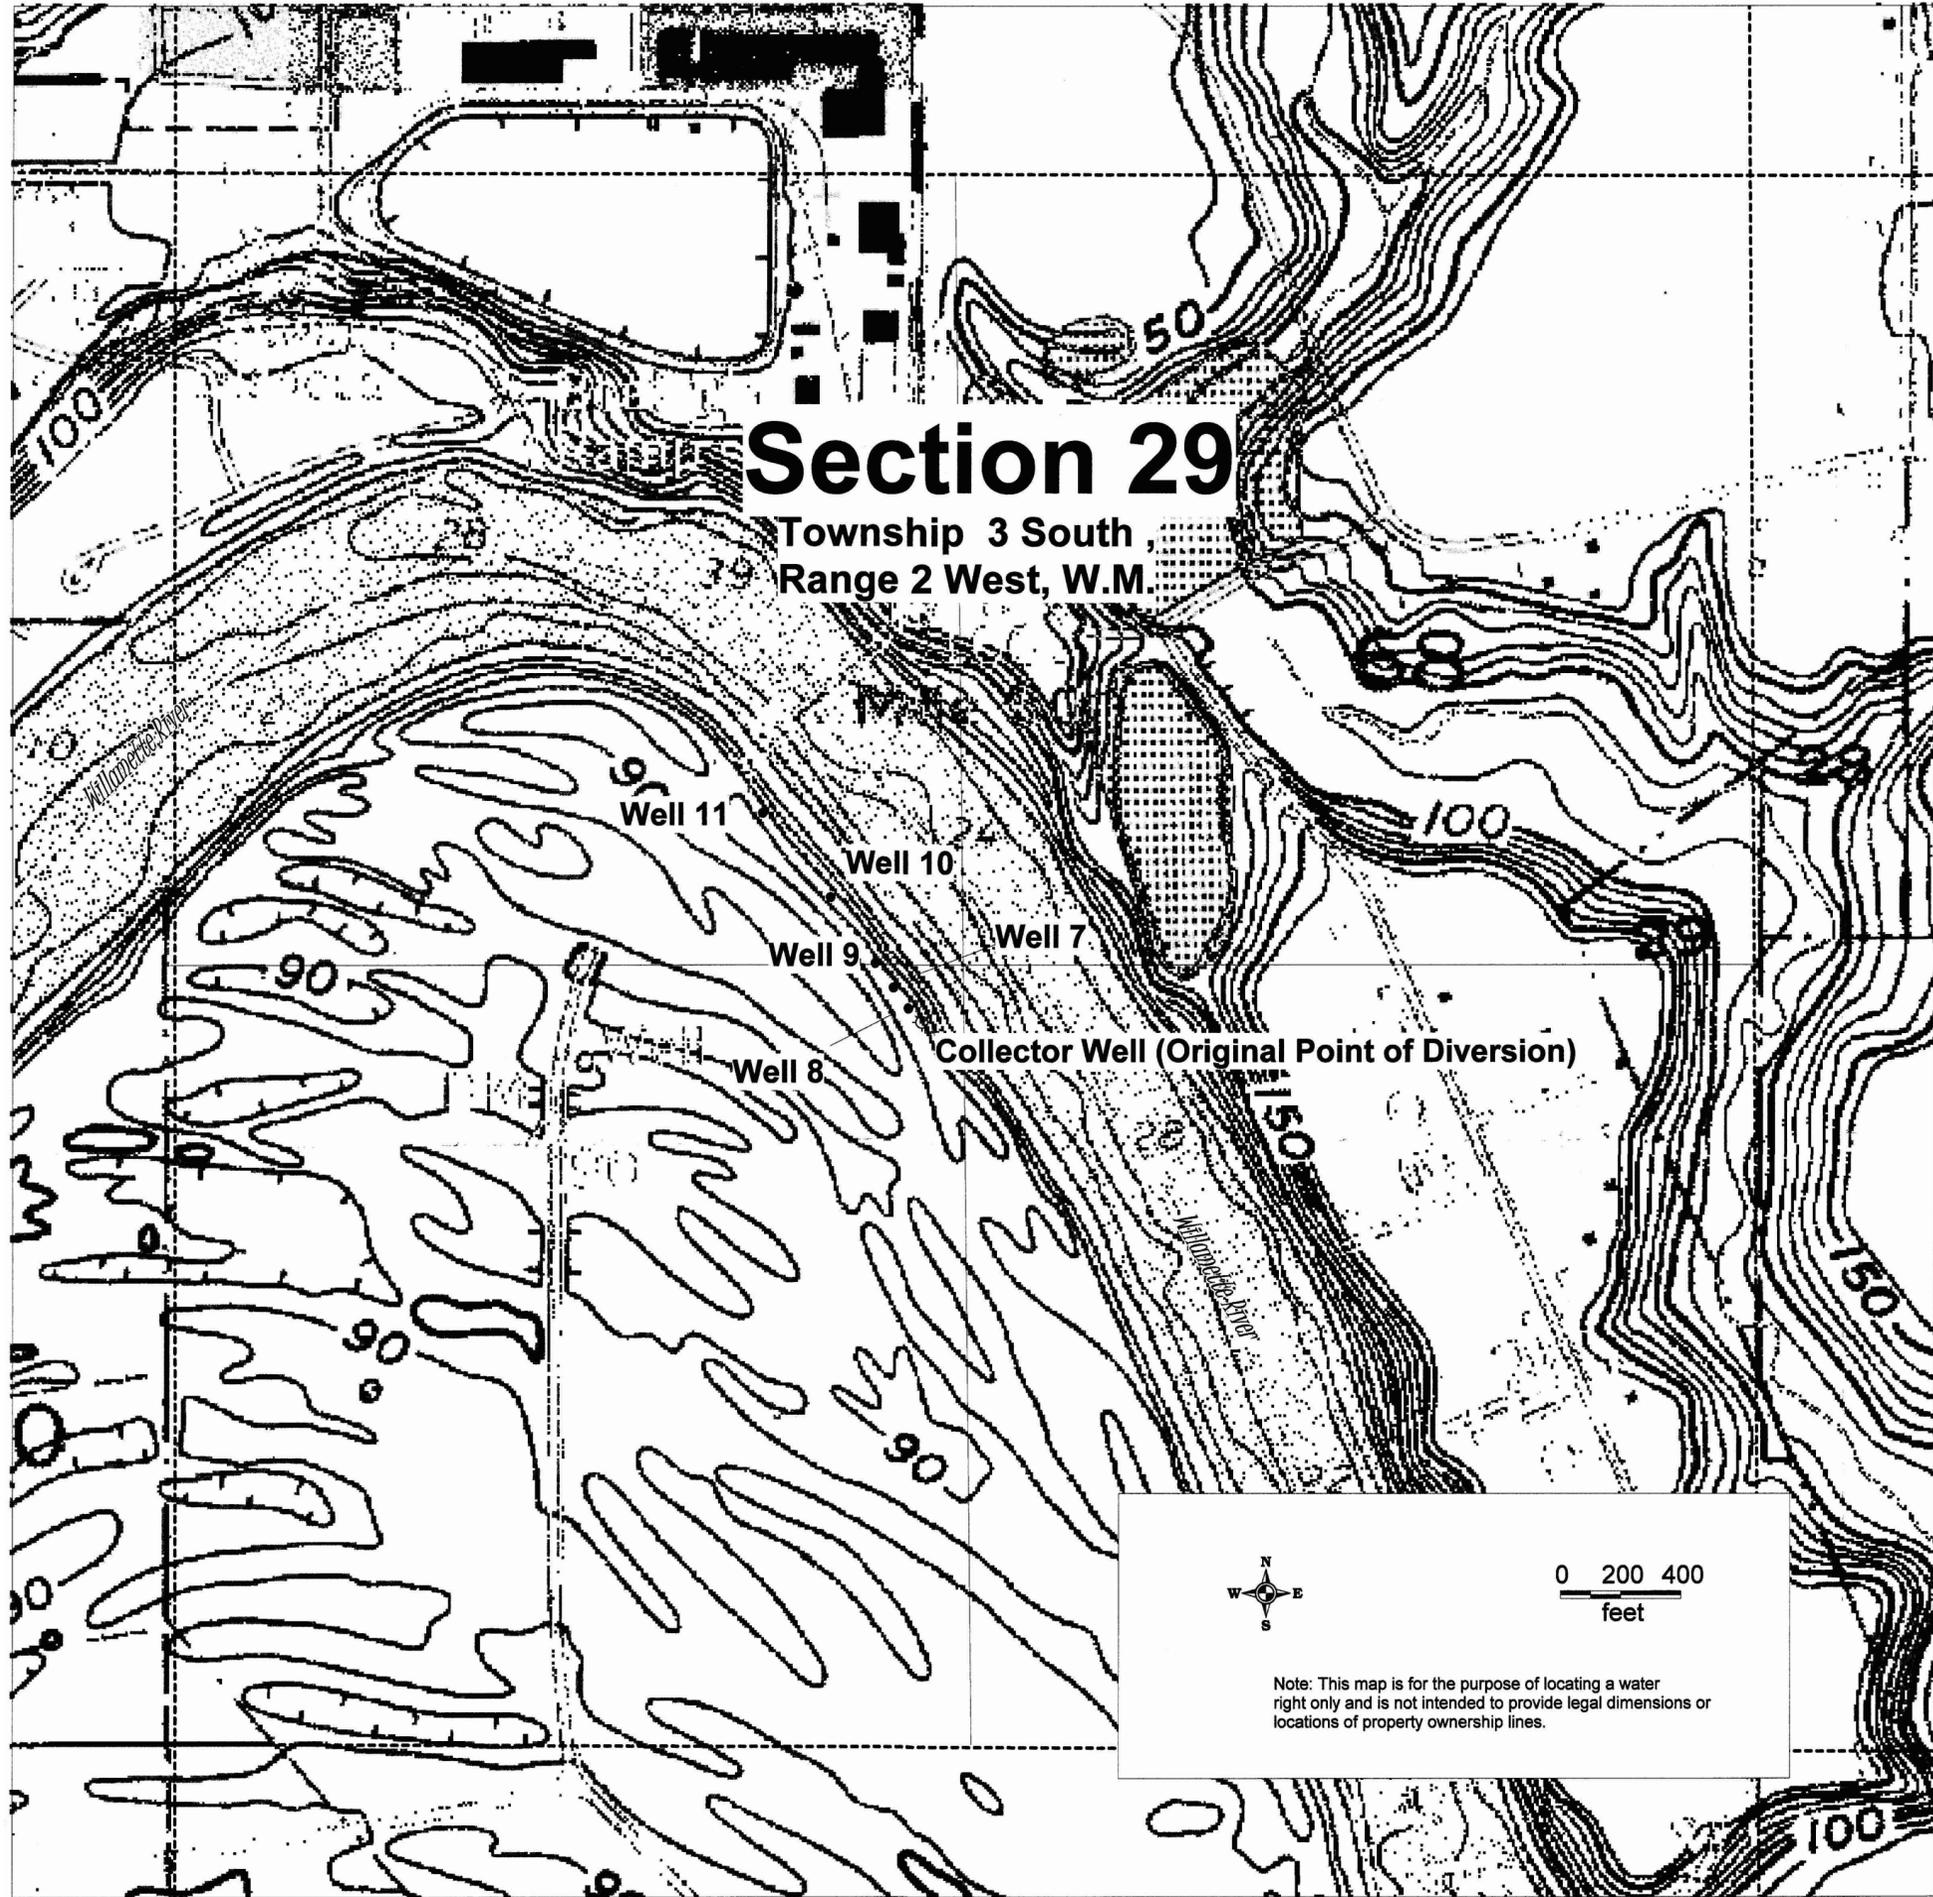

Section 29

Township 3 South,
Range 2 West, W.M.

Collector Well (Original Point of Diversion) - NE 1/4 SW 1/4 Section 29 Township 3 South ,
Range 2 West W.M.; 180 feet south and 2500 feet east from the SW corner of the NW 1/4,
Section 29, Township 3 South, Range 2 West, W.M.

Well 7 - NE 1/4 SW 1/4 Section 29 Township 3 South ,
Range 2 West W.M.; 80 feet south and 2400 feet east from the SW corner of the NW 1/4,
Section 29, Township 3 South, Range 2 West, W.M.

Well 8 - NE 1/4 SW 1/4 Section 29 Township 3 South ,
Range 2 West W.M.; 140 feet south and 2440 feet east from the SW corner of the NW 1/4,
Section 29, Township 3 South, Range 2 West, W.M.

Well 9 - NE 1/4 SW 1/4 Section 29 Township 3 South ,
Range 2 West W.M.; 2330 feet east from the SW corner of the NW 1/4,
Section 29, Township 3 South, Range 2 West, W.M.

Well 10 - SE 1/4 NW 1/4 Section 29 Township 3 South ,
Range 2 West W.M.; 220 feet north and 2180 feet east from the SW corner of the NW 1/4,
Section 29, Township 3 South, Range 2 West, W.M.

Well 11 - SE 1/4 NW 1/4 Section 29 Township 3 South ,
Range 2 West W.M.; 510 feet north and 1950 feet east from the W1/4 corner,
Section 29, Township 3 South, Range 2 West, W.M.

T 9098



0 200 400
feet

Note: This map is for the purpose of locating a water
right only and is not intended to provide legal dimensions or
locations of property ownership lines.