


T.41 S.R.13 W.W.M.

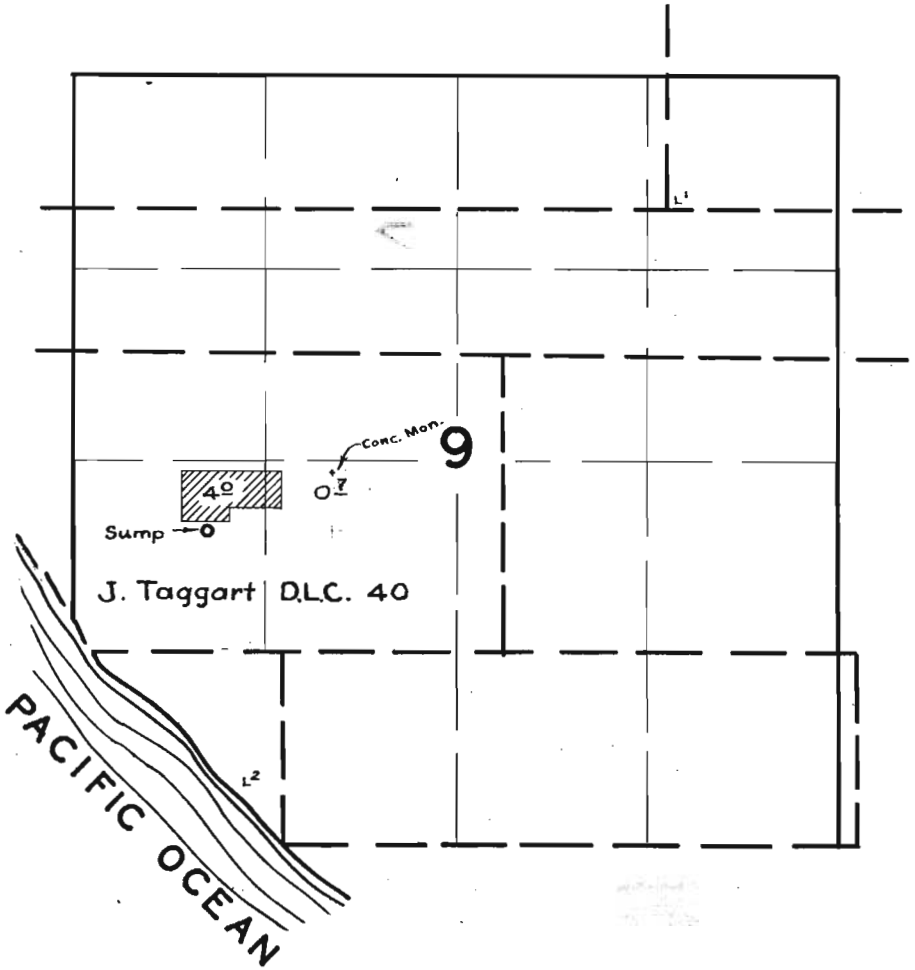

FINAL PROOF SURVEY
UNDER

Application No. G-380 Permit No. G-303
IN NAME OF

Earl H. & Edna Mae Simpson

Surveyed Mar. 21, 1958, by M. B. [Signature]