


Township 6 South, Range 1 East, W.M.

**RECEIVED**

Section 3

JUN 25 1990

WATER RESOURCES DEPT.  
SALEM, OREGON

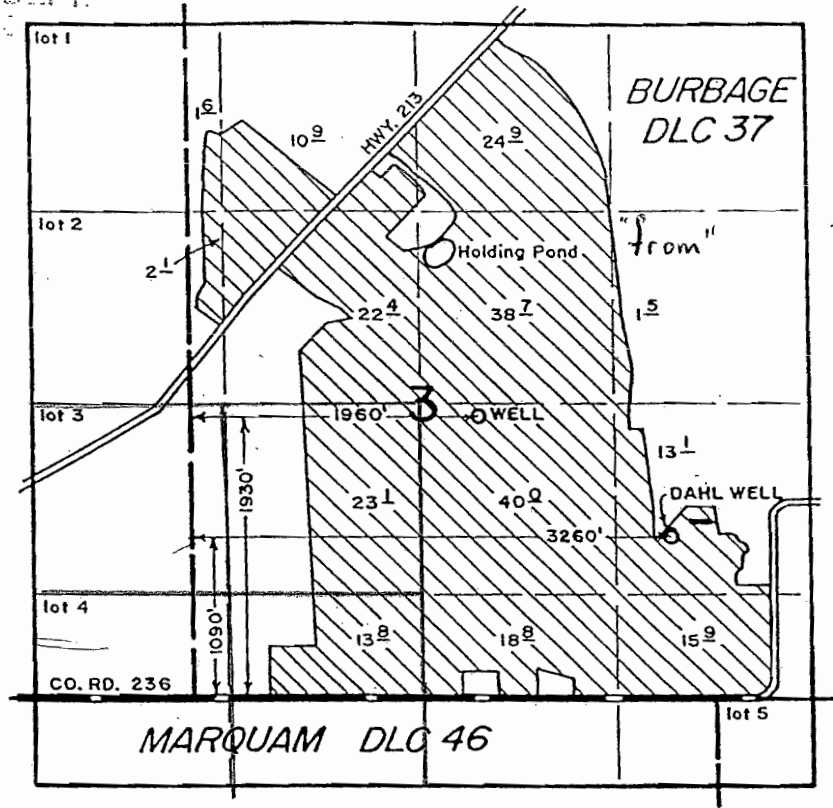

Appl. No. 2-12149  
Per. No. G11688

Application Map  
for  
**KRAEMER FARMS**

Certified Water Right Examiner  
#026 WRE  
*Donald R. Buell*  
Donald R. Buell  
Nov 19, 1987  
STATE OF OREGON

T-9161

**RECEIVED**  
JUN 26 2002  
WATER RESOURCES DEPT.  
SALEM, OR

THIS MAP WAS PREPARED FOR THE PURPOSES OF IDENTIFYING THE LOCATION OF A WATER RIGHT ONLY AND IS NOT INTENDED TO PROVIDE LEGAL DIMENSIONS OR LOCATION OF PROPERTY OWNERSHIP LINES.