
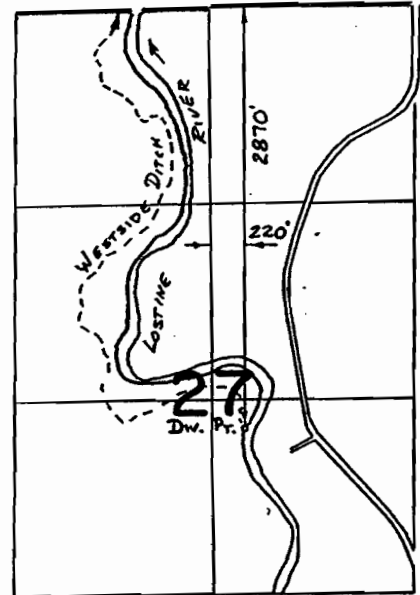


T. 15., R. 43E., W. M.

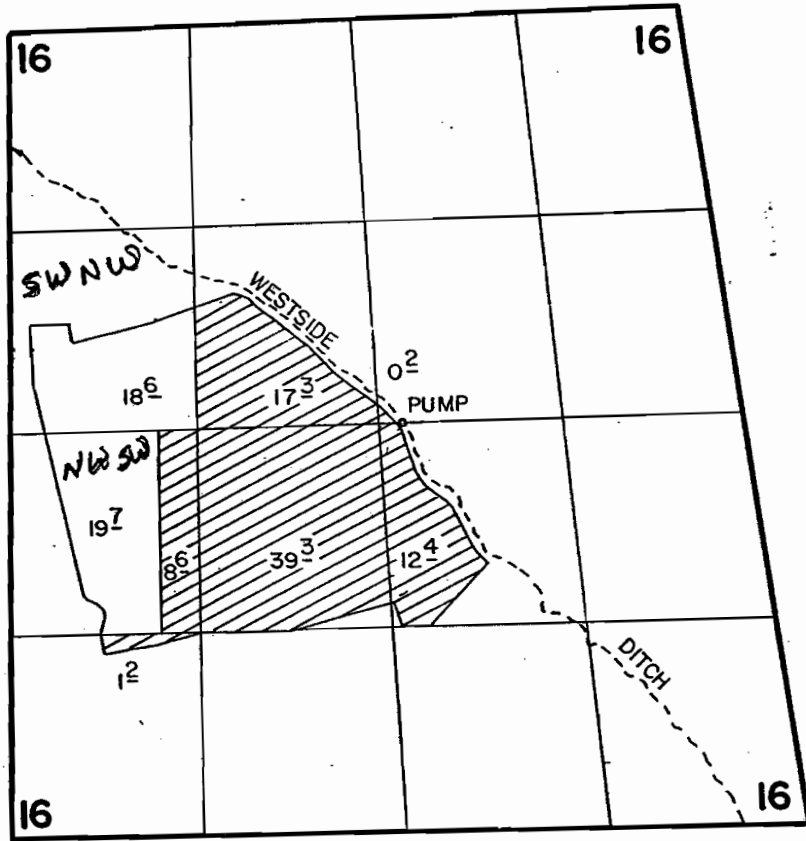

SCALE: 1" = 1320'

FINAL PROOF SURVEY
UNDER

Application No. **58547** Permit No. **44274**
IN NAME OF

ARNILDO J. UPPIANO

Surveyed **8-13-1985**, by **V.L. CHURCH**