


T.4N.R.28E.W.M.

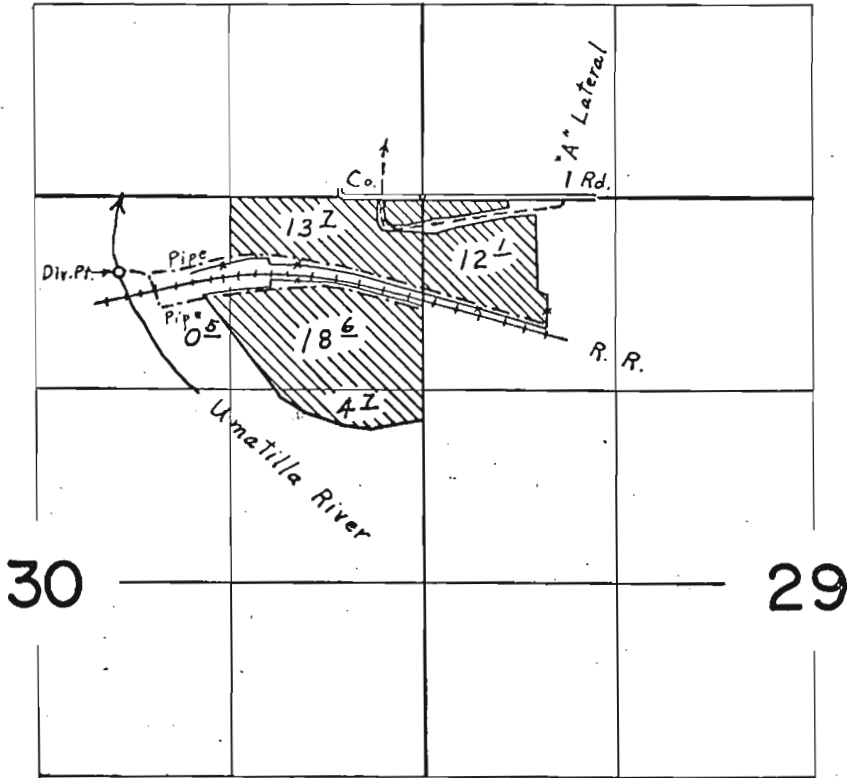

Div. Pt. located 520' S. & 2070' W. from the N.E. Cor. Sec. 30

FINAL PROOF SURVEY
UNDER

Application No. 41608.... Permit No. 31030....
IN NAME OF
J. L. BACUS

.....
Surveyed June 27, 1967., by L. E. Gould.....