


T.21 & 22S.R.5W.W.M.

RECEIVED
JAN - 6 1998
WATER RESOURCES DEPT.
SALEM, OREGON
RECEIVED
JAN 13 1998
WATER RESOURCES DEPT.
SALEM, OREGON

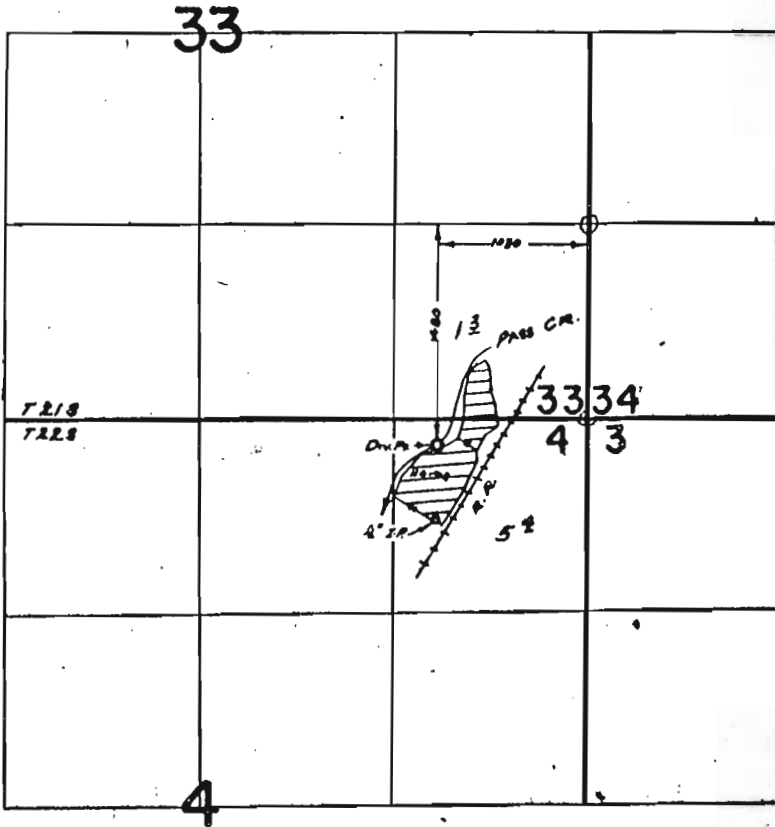

FINAL PROOF SURVEY
UNDER

Application No. 41940 Permit No. 31189
IN NAME OF

WILLIAM C. & NONDYS V. WOOLEY

Surveyed JUNE 8, 1970, by B. MUGEN