


Cert. 34395

T.3S.R.38E.W.M.

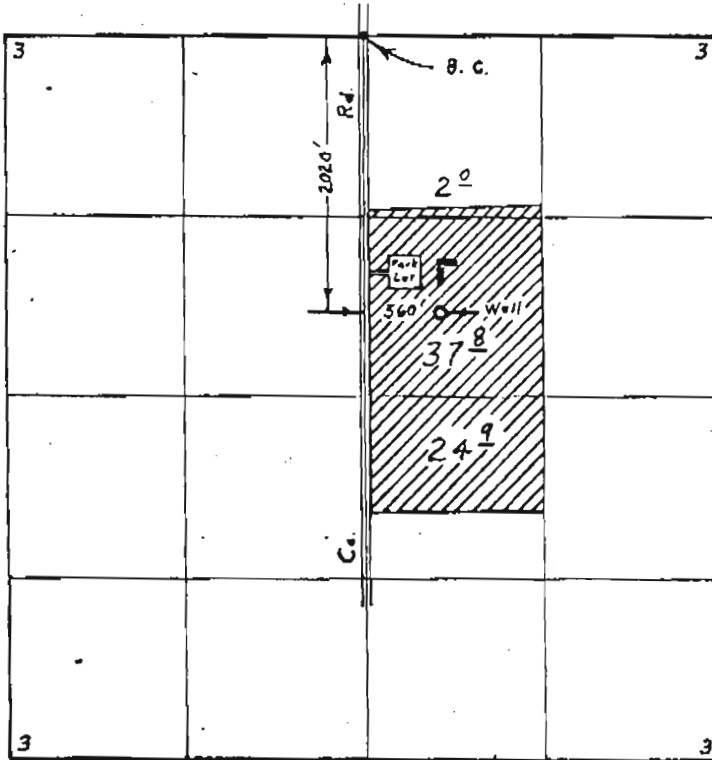

FINAL PROOF SURVEY UNDER

Application No. G-3155 Permit No. G-2969
IN NAME OF

THE LA GRANDE COUNTRY CLUB

Surveyed Oct. 27, 1966, by L. E. Gould