


T.4S., R.3W., W.M.

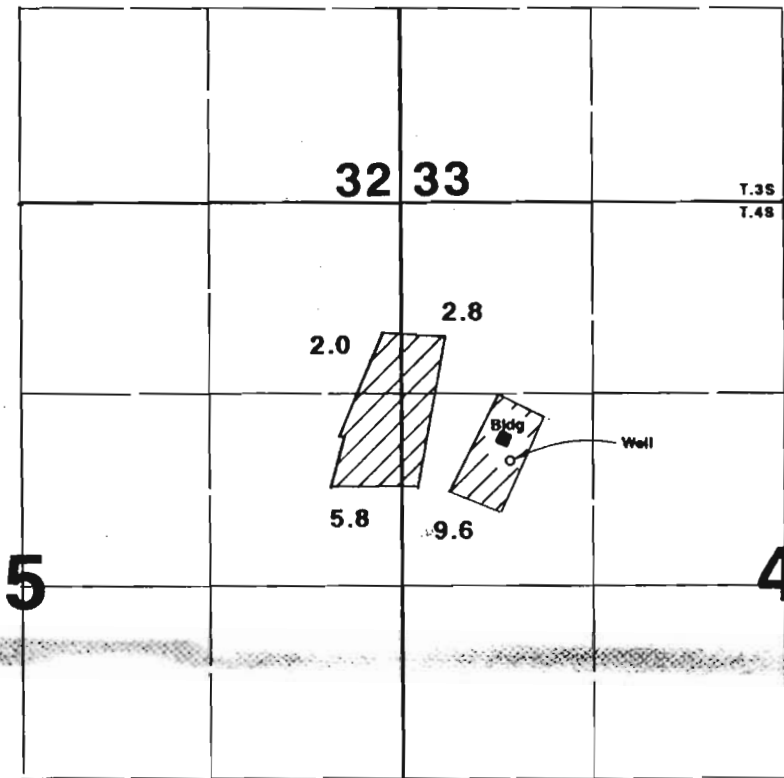

Area Irrigated

Well located 870'N & 750'E from W $\frac{1}{4}$ corner Section 4.

RECEIVED

SEP 25 1997

**WATER RESOURCES DEPT.
SALEM, OREGON**

Final Proof Survey

Application #: G-12540

Permit #: G-11416

In Name Of

Kenneth L. Evenstad

Surveyed on September 14, 1997 by JM Schuette

THIS MAP WAS PREPARED FOR THE PURPOSE OF IDENTIFYING THE LOCATION OF A WATER RIGHT ONLY AND IS NOT INTENDED TO PROVIDE LEGAL DIMENSIONS OR LOCATION OF PROPERTY OWNERSHIP LINES.

