

RECEIVED

FINAL PROOF SURVEY
AND
CLAIM OF BENEFICIAL USE
LOCATED IN

MAR 8 2000

WATER RESOURCES DEPT.
SALEM, OREGON


SE 1/4, NE 1/4, SECTION 28, T.6N., R.34 E., W.M
UMATILLA COUNTY OREGON

TRANSFER 7927 SPECIAL ORDER VOLUME 52, PAGE 933

APPLICANTS: TIM M. AND LINDA L. DeRUWE

ADDITIONAL POINT OF APPROPRIATION

PERMIT G-10560

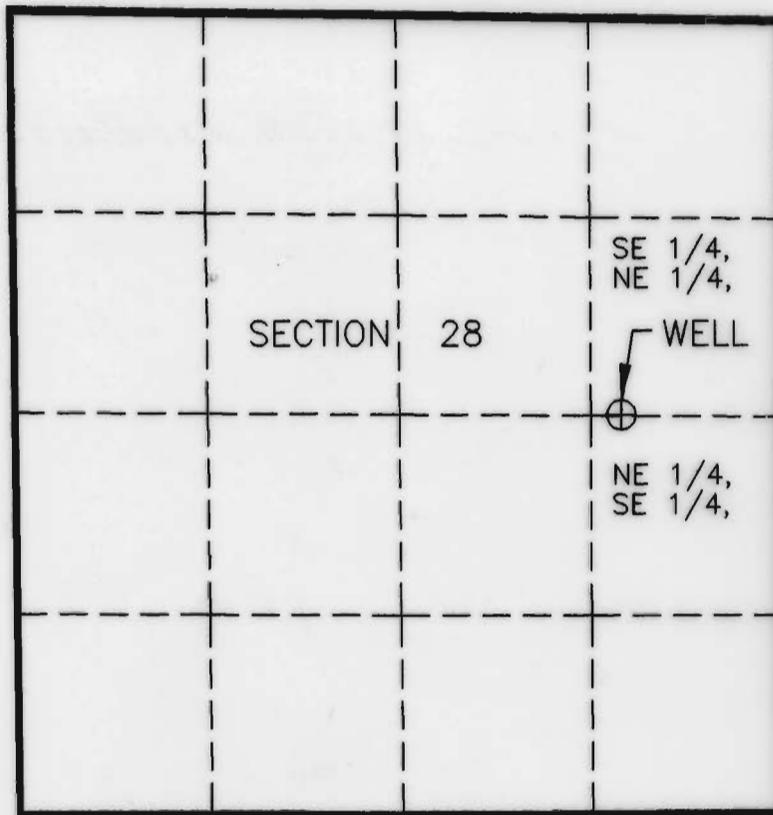

NOTE:
PLACE OF USE
HAS NOT CHANGED



1320' 0' 1320'
1" = 1320'

LOCATION OF WELL:
THE ADDITIONAL POINT OF APPROPRIATION
IS WITHIN THE SE 1/4, NE 1/4, SECTION 28, T.6N.,
R.34E., AND IS 2,705 FEET NORTH AND 1,120 FEET
EAST OF THE SOUTHEAST CORNER OF SECTION 28.

THIS MAP IS PREPARED
FOR THE EXPRESS
PURPOSE TO SHOW WATER
APPROPRIATION AND USE.
IT IS NOT INTENDED TO
SHOW OR LOCATE
PROPERTY OWNERSHIP
LINES.



DENNIS L. GAYLORD,
CWRE
71614 S.W. LAKE DRIVE
PENDLETON, OR 97801
(541)-276-6260 ©

February 28, 2000

Drawn by: Mill Creek Drafting

RENEWS JUNE 20, 2001