

RECEIVED


DEC 27 1994

WATER RESOURCES DEP.
SALEM, OREGON

T.26 S.R.4 W.W.M.

Application No. R-80561

Permit No. 72053

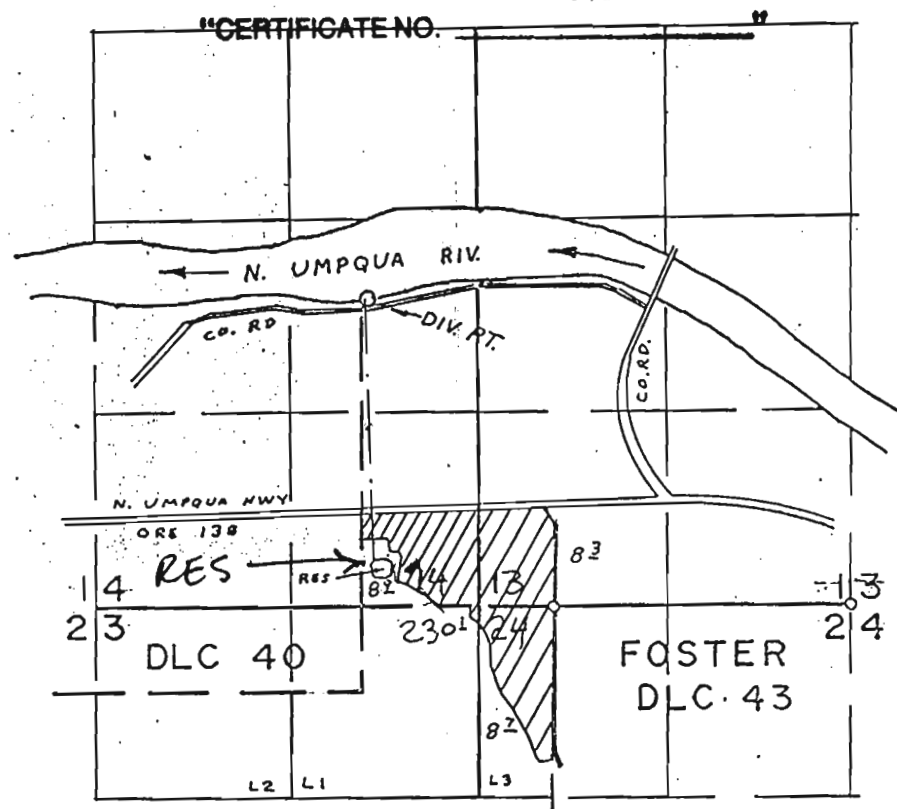

DIV. PT. LOC. 2080' N & 770' W FROM SE COR. SEC. 14

FINAL PROOF SURVEY
UNDER

Application No. 50476 Permit No. 37316
IN NAME OF

GLEN W. WECKS

Surveyed AUG 29 1974 by L. H. NUNN