


RECEIVED

T.9S.R.4W.W.M.

APR 21 1998

WATER RESOURCES DEPT.
SALEM, OREGON

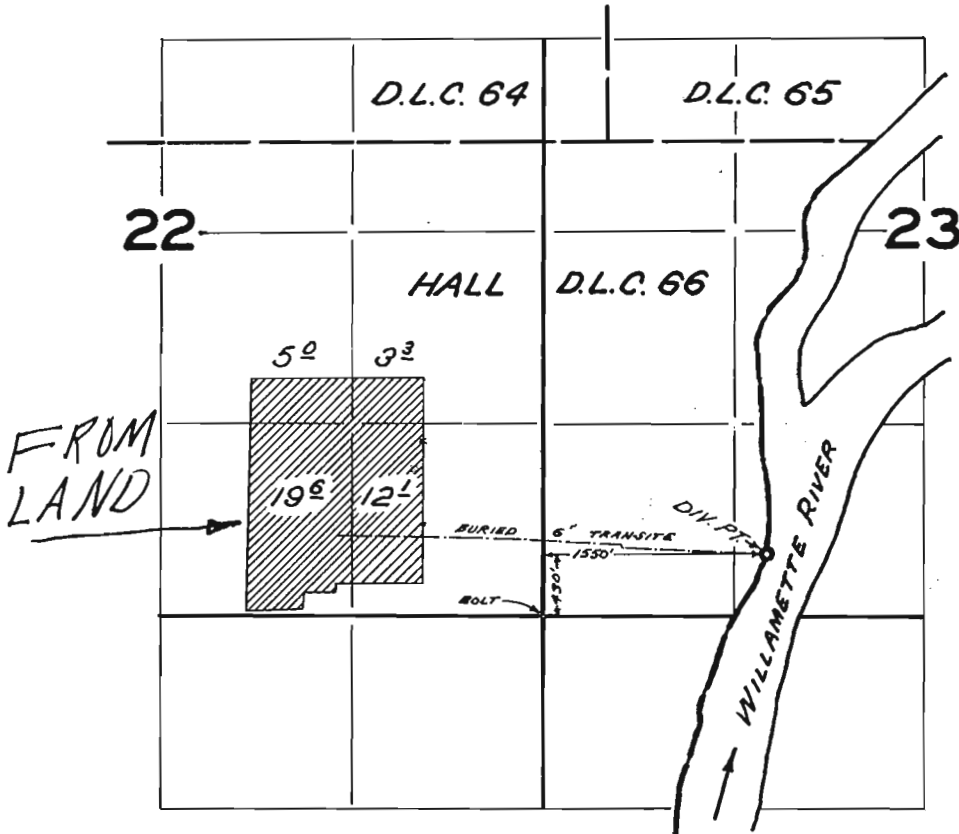

FINAL PROOF SURVEY
UNDER

Application No. 42121 Permit No. 31399
IN NAME OF

DANE J. PURVINE

Surveyed MAR 31 1967, by W.J. RUPPERT