


# T40S. R18 & 19E. WM.

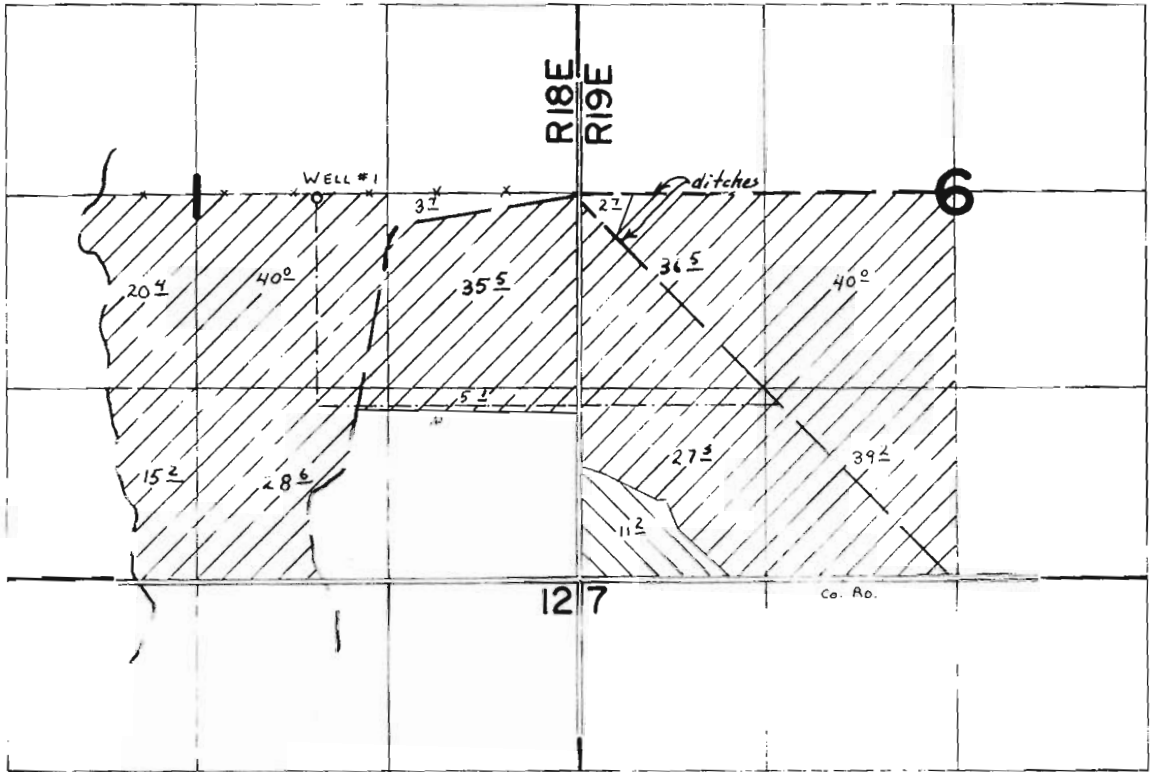

WELL LOG: 2650' N. & 1820' W. TO SE. COR. SEC. 1.

▨ - SUPPLEMENTAL IRRIGATION

▧ - PRIMARY IRRIGATION

## FINAL PROOF SURVEY UNDER

Application No. G-7472 Permit No. G-6956  
IN NAME OF

*Portello Ranch Company, Inc.*

Surveyed JUNE 24 1978, by C. L. HUGHES