



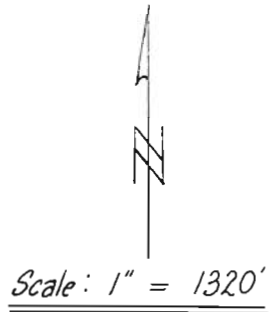


T.8S., R.38 & 39E., W.M.

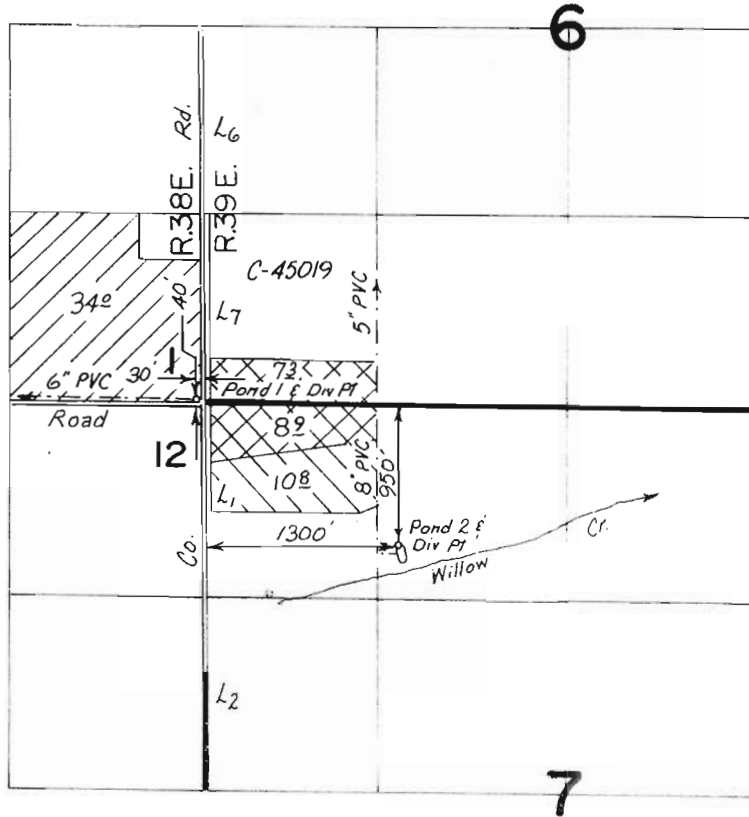

FINAL PROOF SURVEY UNDER

Application No. G10666 Permit No. G9888...
 IN NAME OF
 MICKEY & LINDA COWAN
 & PHILLIP R. STEVENSON.....

Surveyed ...6-A... 1987, by Kern Church.....

-  Pond 1
Supplemental
-  Pond 2
Primary
-  Supplemental