


OCT-29-02 TUE 10:50

PACIFIC SURVEY SUPPLY

FAX NO. 15417723825

P.01

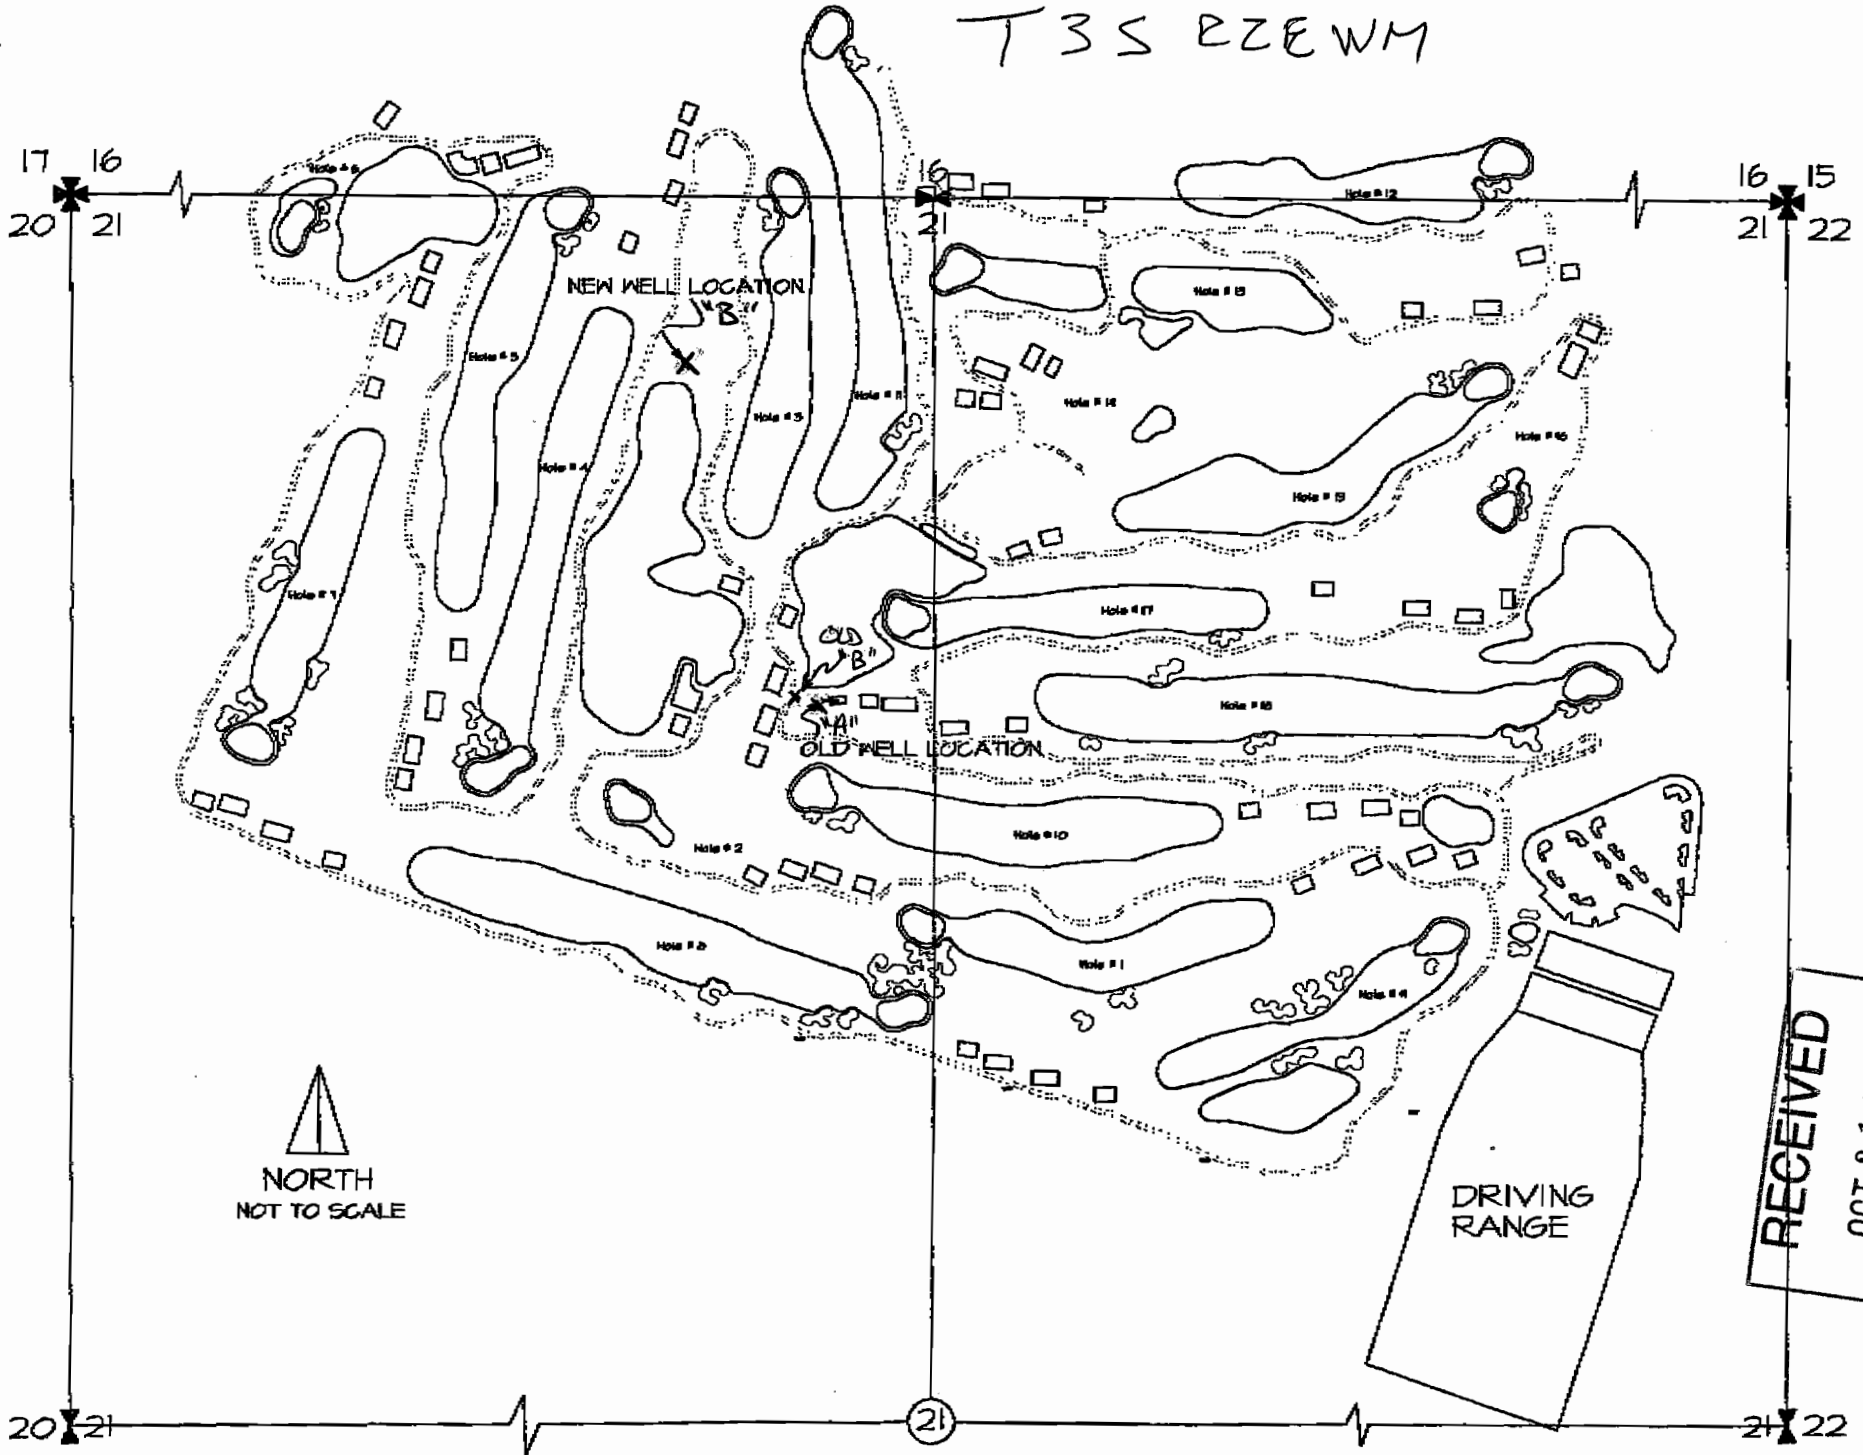

RECEIVED
 OCT 31 2002
 WATER RESOURCES DEPT
 SALEM, OREGON

T-9279